

Name

Service No.

Address 11 CARY AVENUE

Location

Kind of Pipe PVC

Size 6"

Size of Main 8"

Repair—Renewal—New Service RENEWAL PROJECT 99-12

Location

Date

Material

Amount

Total

Date

Amount


10/4/99

15' 6" PVC

DATE 10/4/99

TOWN OF LEXINGTON — BOARD OF PUBLIC WORKS
SEWER DIVISION

Sketch of Service Here

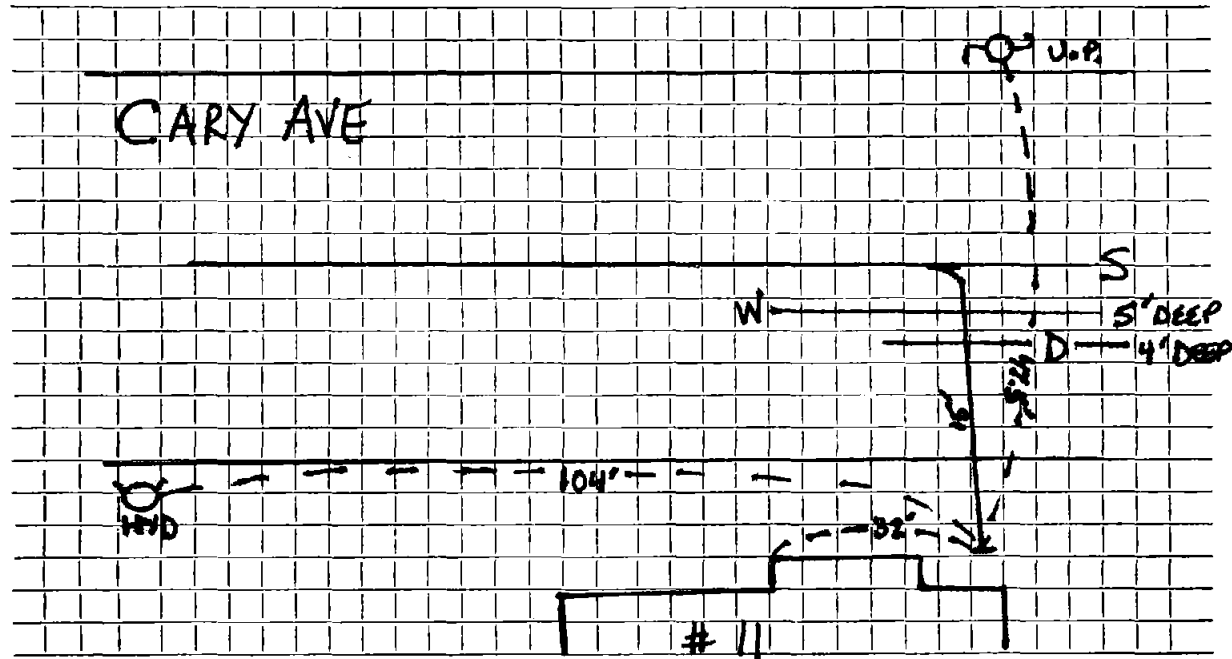

Connection made in Street. Work completed

Remarks: SERVICE INSIDE PROPERTY IS ALREADY RENEWED TO 6" PVC (SDR).....

SEWER SERVICE DIRECTLY ABOVE WATER MAIN AND UNDER DRAW.....

FIELD BOOK 99-12-1 : PG. 16.....

D.F.