




DATE 10-4-1999

TOWN OF LEXINGTON — BOARD OF PUBLIC WORKS  
SEWER DIVISION

Sketch of Service Here

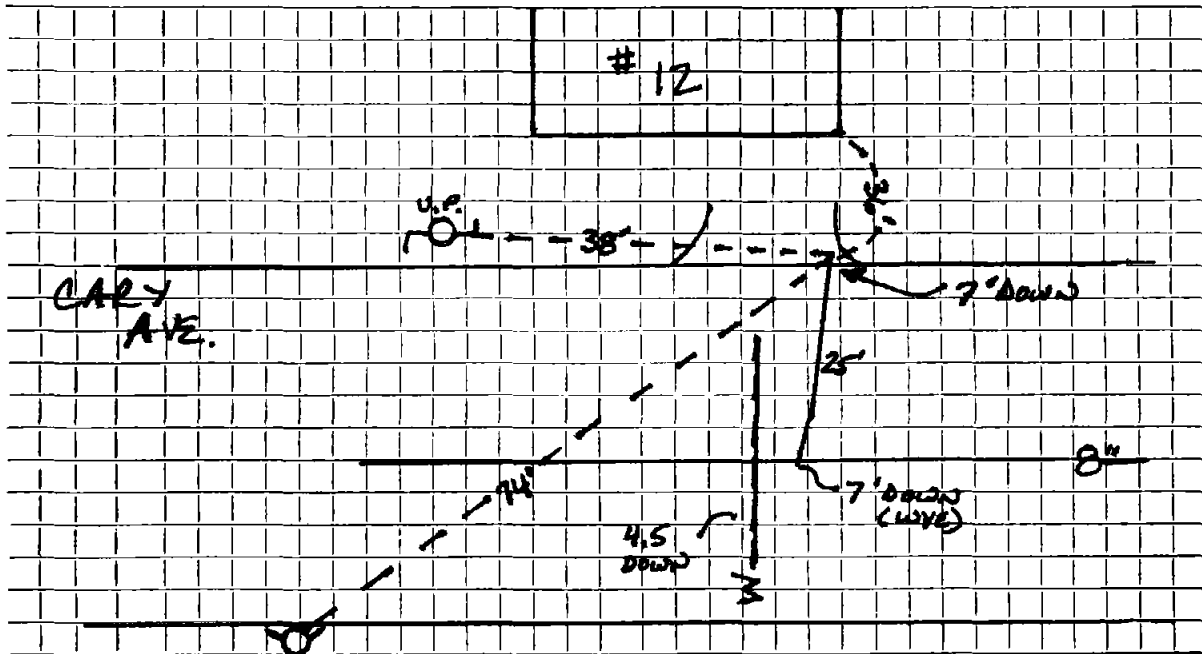

Connection made in ..... Street. Work completed .....

Remarks: . EXIST. WATER SERVICE APPROX. 2.5' FROM SEWER WYE . AND 2.5' ABOVE .....

.. FIELD BOOK 99-12-1, PG 10 .....

D.F.