




DATE 10-4-1999

TOWN OF LEXINGTON — BOARD OF PUBLIC WORKS  
SEWER DIVISION

Sketch of Service Here

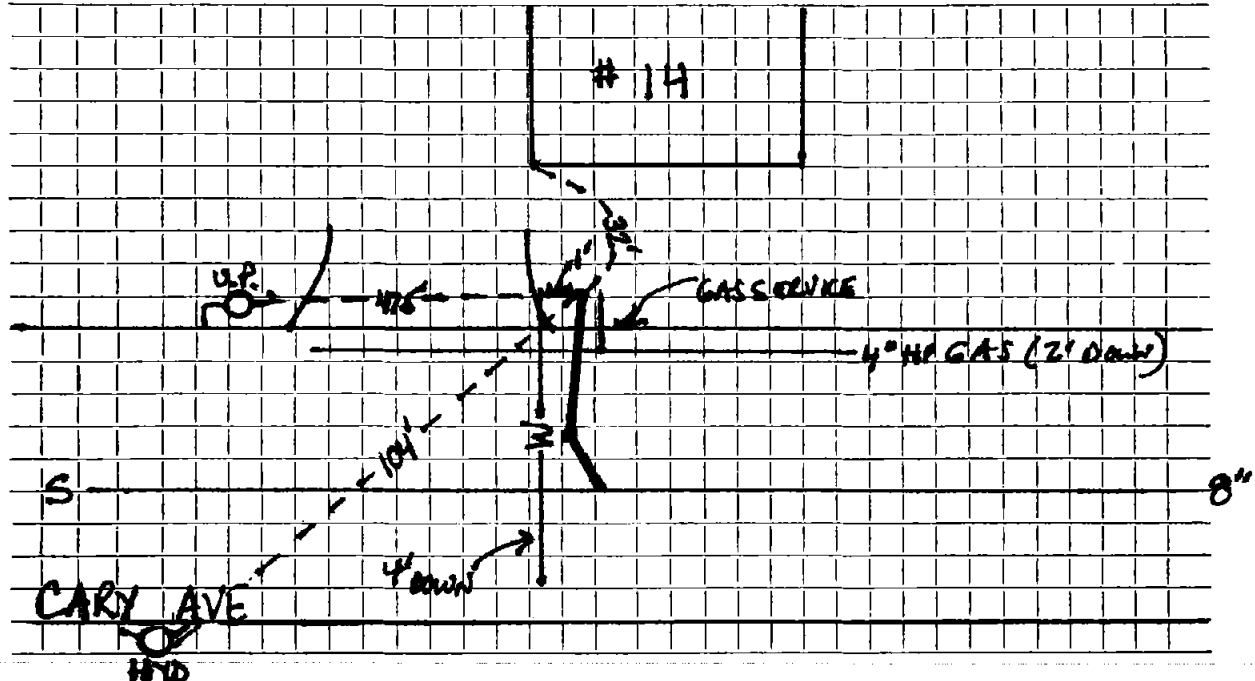

Connection made in ..... Street. Work completed .....

Remarks: GAS SERVICE ADJ/ABOVE SEWER SERVICE, 3' DOWN / 4" HP GAS 2' DOWN  
... SUB. 4' DOWN, WATER SERVICE 1' FROM SEWER SERVICE  
FIELD BOOK 99-12-1 PG. 11

DF