


DATE 10-6-1999

TOWN OF LEXINGTON — BOARD OF PUBLIC WORKS
SEWER DIVISION

Sketch of Service Here

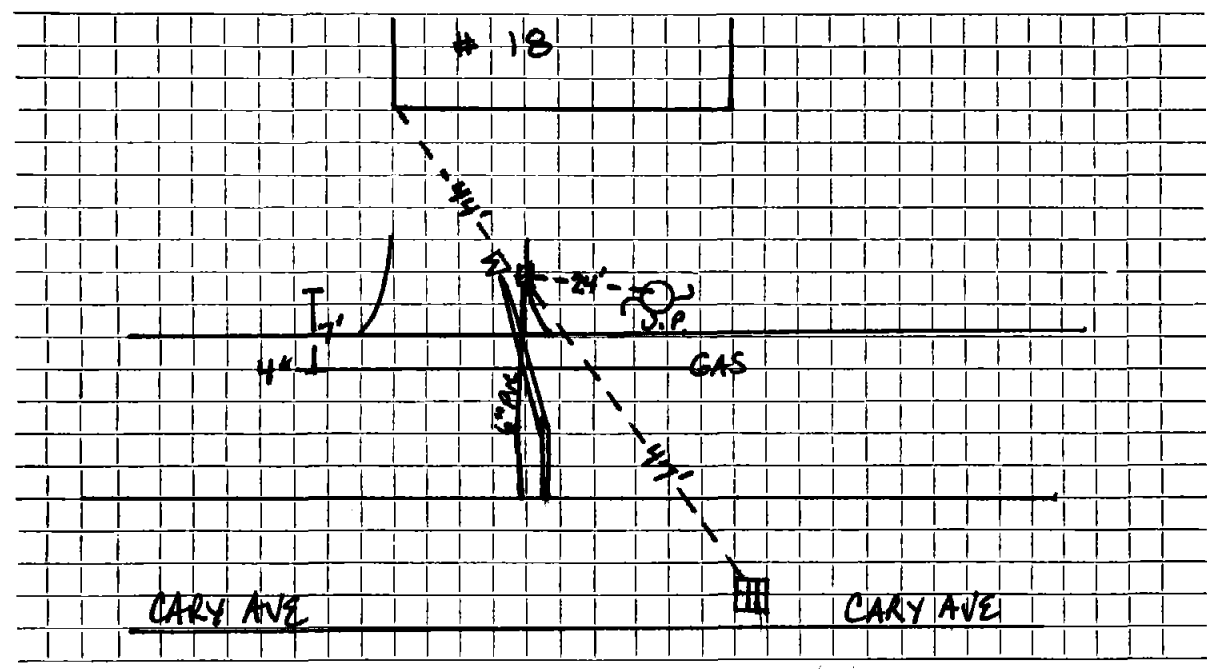

Connection made in Street. Work completed

Remarks: 1" WATER SERVICE CROSSES SEWER SERVICE, 5' DOWN

4" HP GAS MAIN ABOVE SEWER SERVICE 2' DOWN

FIELD BOOK 99-12-1

Pg 19
D.F.