

Name

Service No.

Address 2 CARY AVE

Location

Kind of Pipe 8" PVC / 6" LATERAL

Size 8" x 6"

Size of Main 8"

Repair—Renewal—New Service RENEWAL CONTRACT 99-12

Location

Date	Material	Amount	Total	Date		Amount
------	----------	--------	-------	------	--	--------


9-30-99

23' 6" PVC

DATE 9-30-99

TOWN OF LEXINGTON — BOARD OF PUBLIC WORKS
SEWER DIVISION

Sketch of Service Here

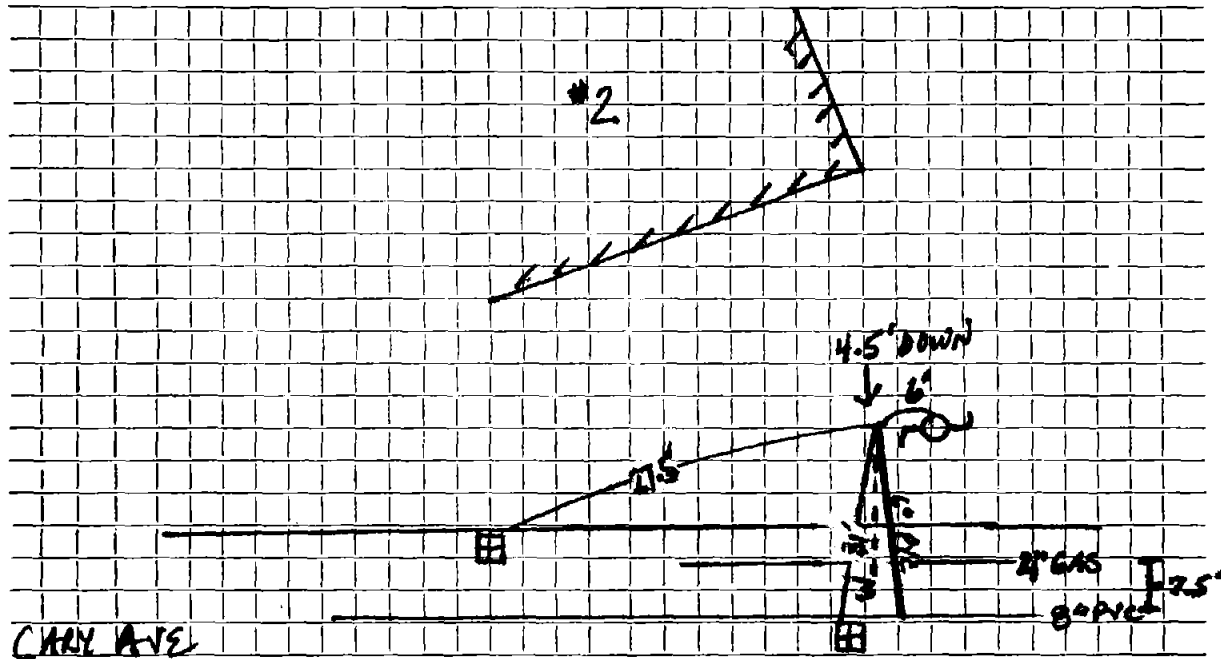

Connection made in Street. Work completed

Remarks: Curb Stop for Water Service Directly Above Street (Also Connection)

1" WATER SERVICE ADJACENT TO SEWER LATERAL

4" HP GAS MAIN 2.75' DOWN

FIELD BOOK 99-12-1, PG 6
D.F.