


DATE 10-6-1999

TOWN OF LEXINGTON — BOARD OF PUBLIC WORKS
SEWER DIVISION

Sketch of Service Here

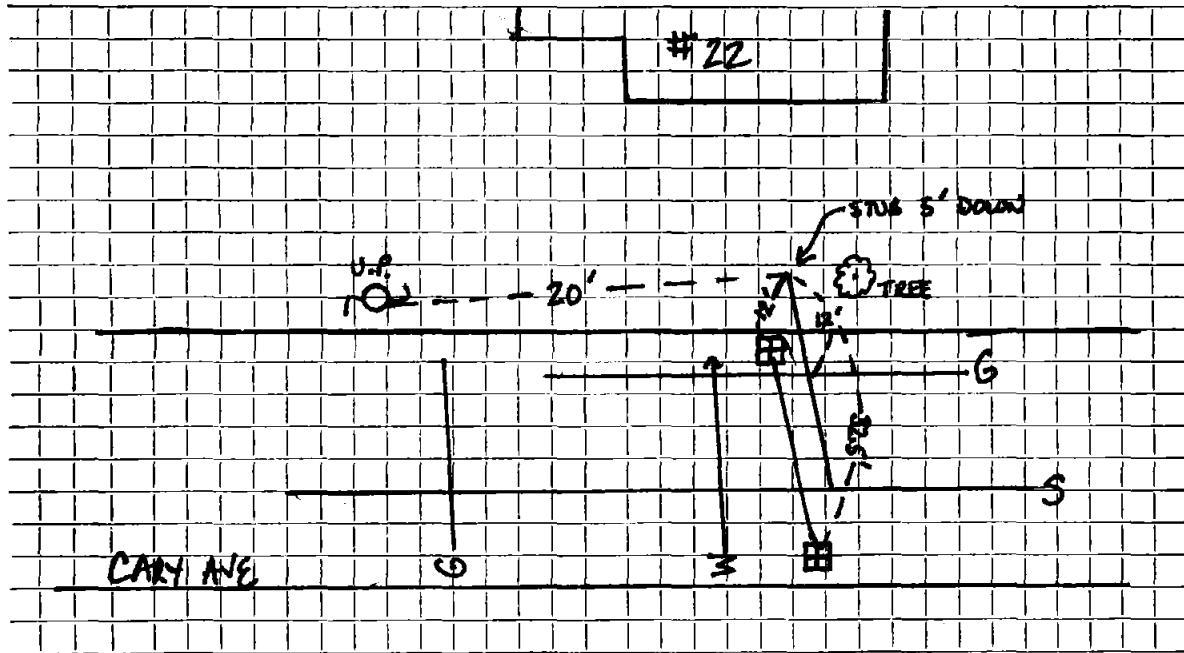

Connection made in Street. Work completed

Remarks: WATER SERVICE 4.5 DEEP : 4.3.5' FROM 12" CMP DRAW PIPE (4' DEEP)

HP GAS 3' DOWN FROM PAVEMENT

GAS SERVICE 3' DEEP

[EXIST^{3rd} SERVICE HEADING TOWARDS DRIVEWAY ABANDONED]

FIELD BOOK 99-12-1 Pg 21

D.F.