




DATE 10-7-1999

TOWN OF LEXINGTON — BOARD OF PUBLIC WORKS

SEWER DIVISION

Sketch of Service Here

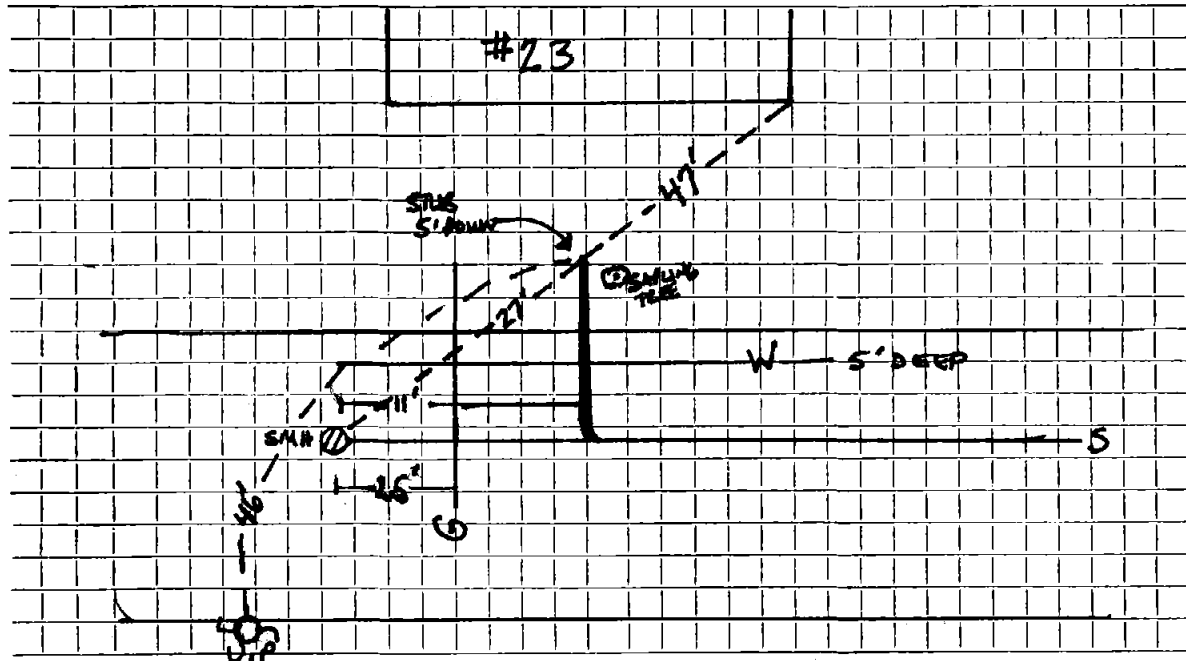

Connection made in ..... Street. Work completed .....

Remarks: SDR SERVICE INSIDE PROPERTY ALREADY IN PLACE  
2" GAS SERVICE 2' DOWN / SEWER SERVICE CROSSES UNDER WATER MAIN 1' BELOW

FIELD BOOK 99-12-1 P622  
D.F.