

Name

Service No.

Address 26 CARY AVE

Location

Kind of Pipe PVC

Size 6"

Size of Main 8"

Repair—Renewal—New Service

RENEWAL : PROJECT 99-12

Location

Date	Material	Amount		Total		Date		Amount
------	----------	--------	--	-------	--	------	--	--------


10-7-1999

22' 6" PVC

DATE 10-7-1999

TOWN OF LEXINGTON — BOARD OF PUBLIC WORKS
SEWER DIVISION

Sketch of Service Here

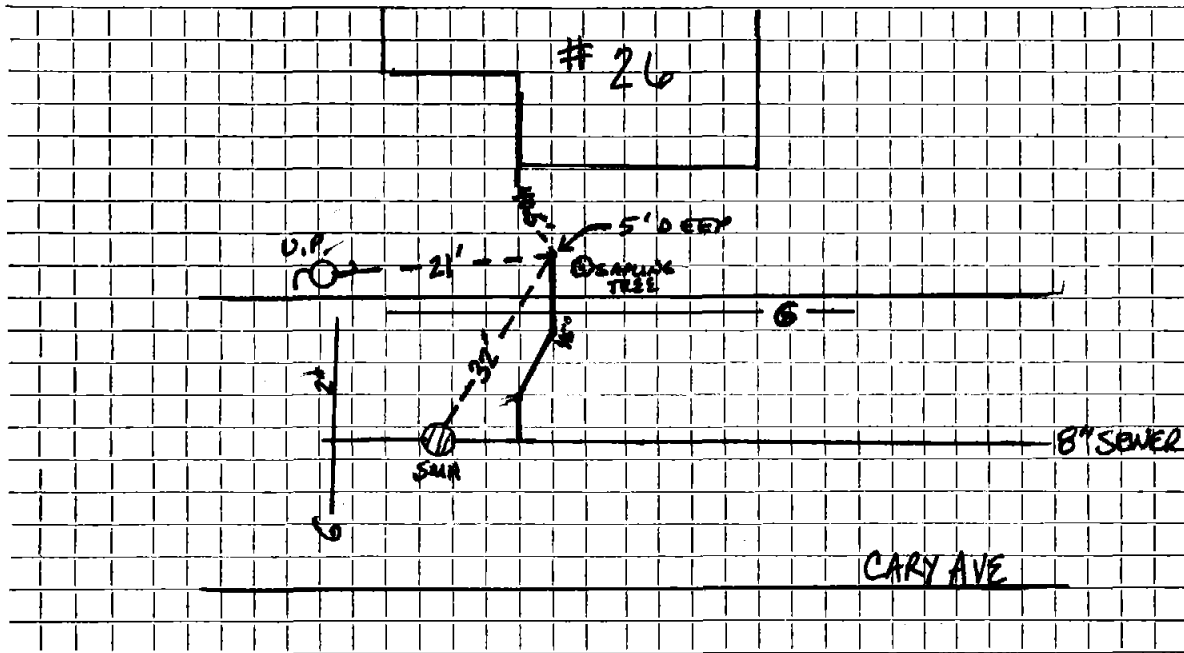

Connection made in Street. Work completed

Remarks: GAS MAN 1' DEEP

FIELD BOOK 99-12-1 PG 24

D.F.