


DATE 10-8-1999

TOWN OF LEXINGTON — BOARD OF PUBLIC WORKS
SEWER DIVISION

Sketch of Service Here

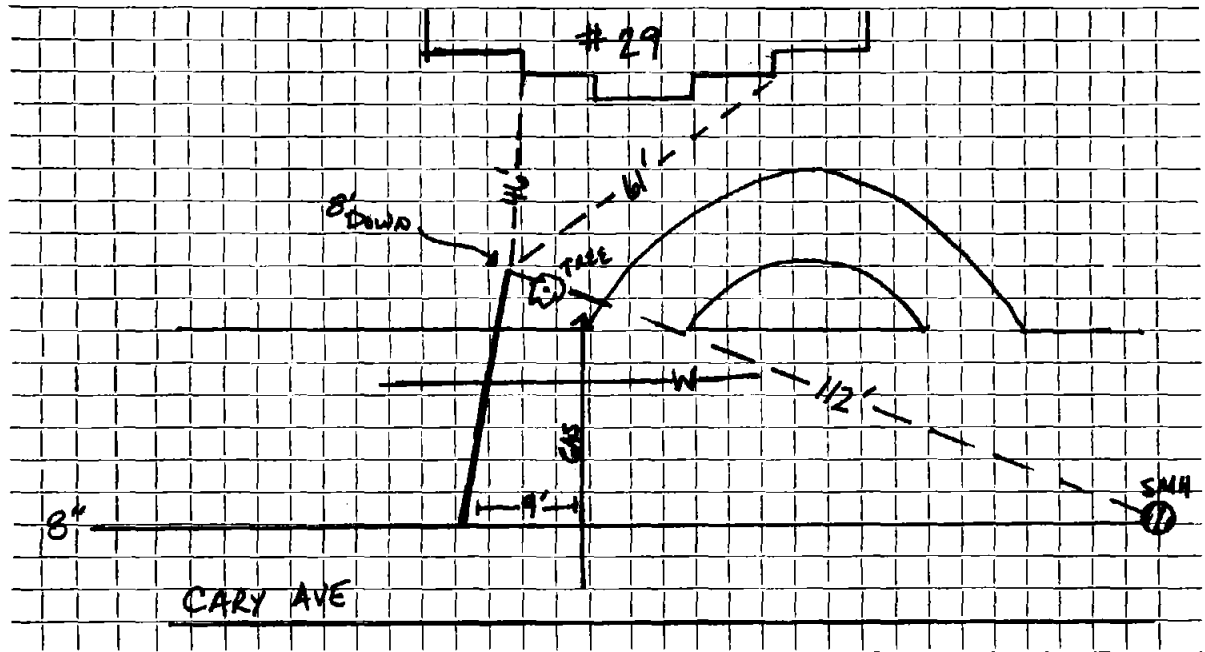

Connection made in Street. Work completed

Remarks: GAS SERVICE 9' FROM SEWER LAT / 1' DOWN

8" WATER MAIN 4.5' DEEP

SERVICE STOPPED @ TREE WHERE VITAL ROOTS WERE ENCOUNTERED.

FIELD BOOK 99-12-1 ^{Pg} 26
D.F.