


DATE 10-13-1999

TOWN OF LEXINGTON — BOARD OF PUBLIC WORKS
SEWER DIVISION

Sketch of Service Here

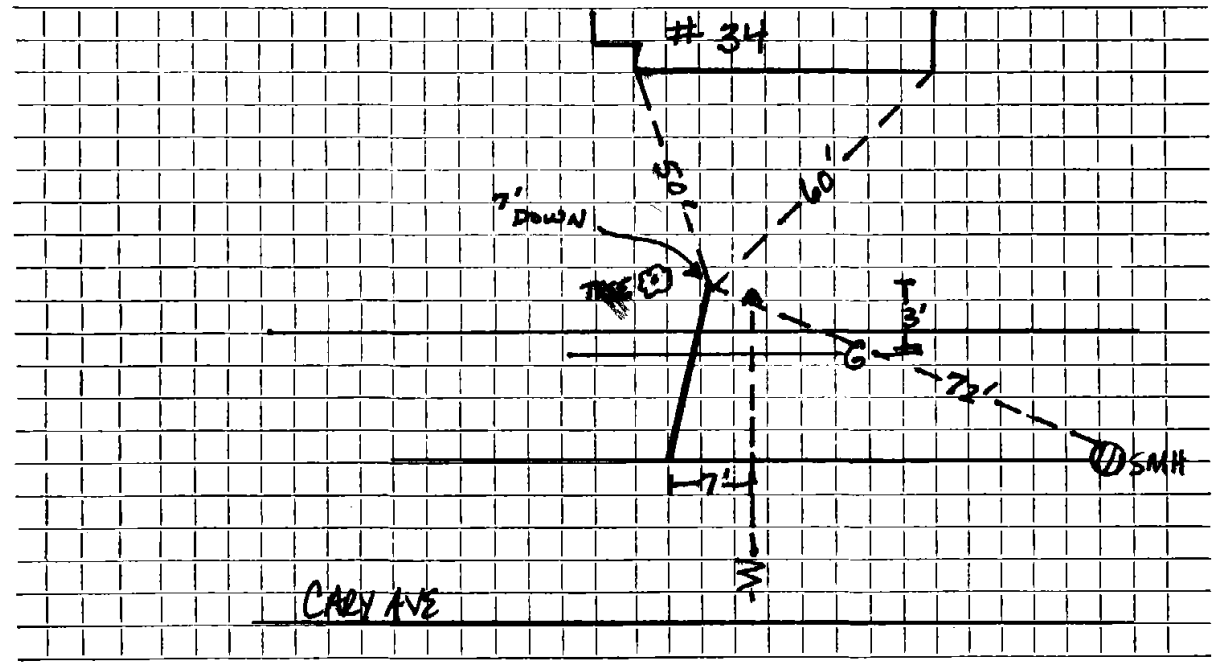

Connection made in Street. Work completed

Remarks: WATER SERVICE 7' FROM SEWER WYE / S' DOWN } "ADJACENT TO SUB END"

GAS MAIN 2' DOWN

PG
FIELD BOOK 79-12-1 28
D.F.