

Name

Service No.

Address

36 ~~ANDREWS~~ CARY AVE

Location

Kind of Pipe

PVC

Size

6"

Size of Main

8"

Repair—Renewal—New Service

RENEWAL

PROJECT

99-12

Location

Date

Material

Amount

Total

Date

Amount


10-13-1999

19' PVC

DATE 10-13-99

TOWN OF LEXINGTON — BOARD OF PUBLIC WORKS  
SEWER DIVISION

Sketch of Service Here

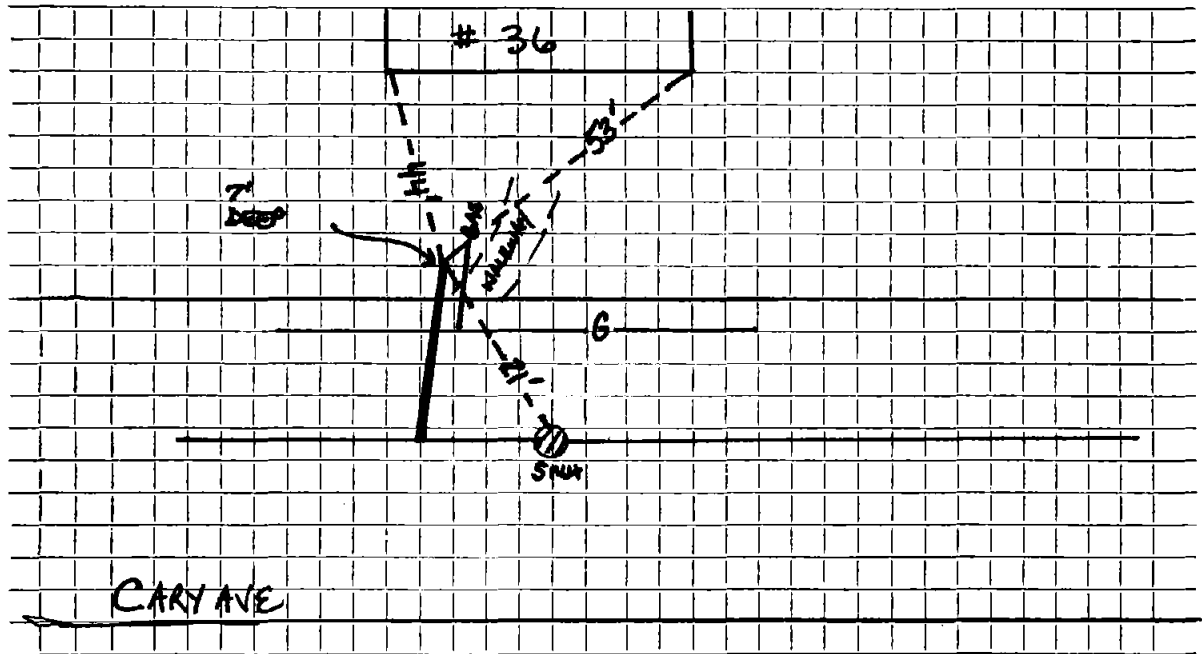

Connection made in ..... Street. Work completed .....

Remarks: GAS MAIN (4") 2' DOWN ~ 4' ABOVE SEWER  
GAS SERVICE TO HSE ABOVE SEWER LATERAL IN TRENCH,  
11' FROM GAS MAIN TO SUB END

FIELD BOOK 99-12-1 PG 29  
D.F.