

Name Carl W. Jacobs

Service No. 116

Address 45 Cary Avenue

Location 45 Cary Avenue

Kind of Pipe

Size

Size of Main

~~Repair—Renewal—New Service~~ Lex. Sewerage Permit 7405

Location AUG 9 1965


Date	Material	Amount	Total	Date	Amount
<del>10/1/63</del>	<del>12.2' 6" A.C.</del>			<del>7-30-65</del>	
	installed by contractor				<i>Deposit</i>
	@ 6.00 per foot	73 20		10- - 63	73 20
	BILL WHEN CONNECTED			12.2' 6" A.C.	
7-30-65	35' 6" Transite pipe				

DATE \_\_\_\_\_

**TOWN OF LEXINGTON — BOARD OF PUBLIC WORKS**  
**SEWER DIVISION**

Sketch of Service Here

**45**

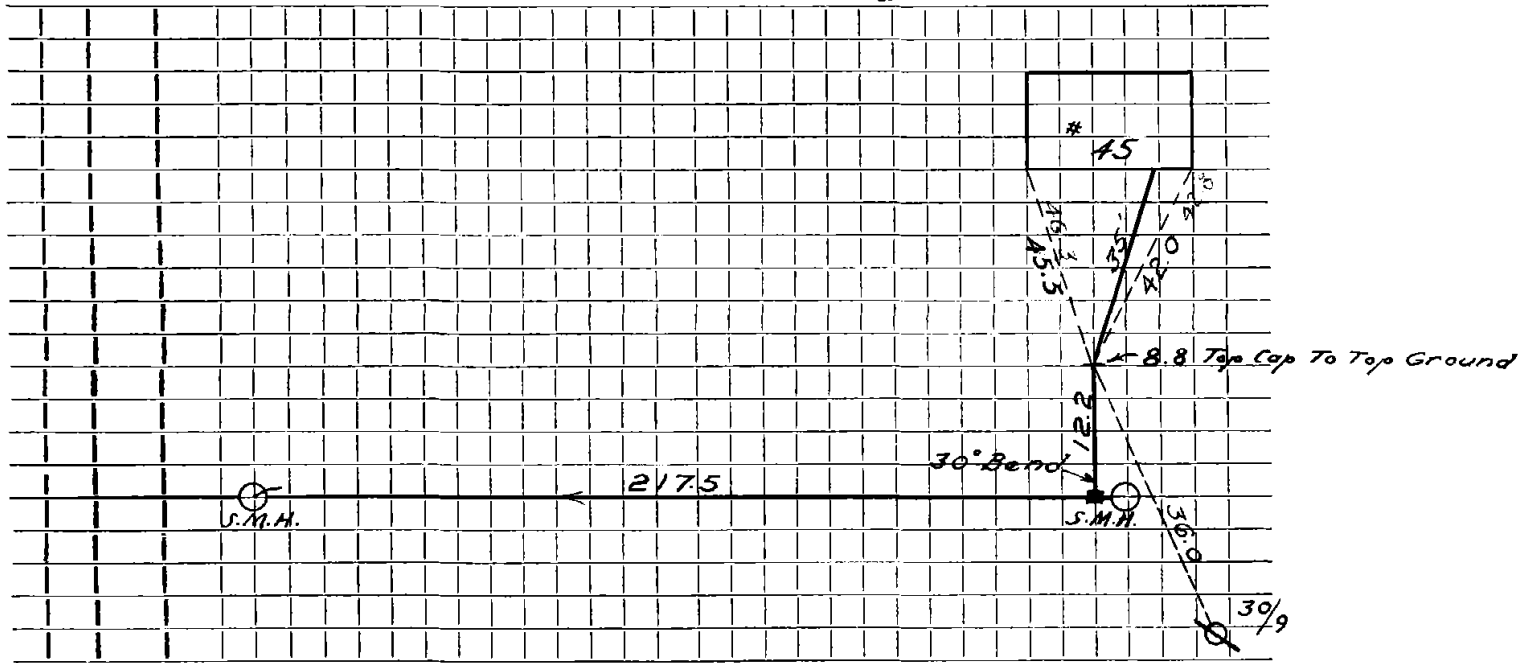

Connection made in ..... Street. Work completed .....

Remarks: .....  
.....  
.....