

Name John Faucette

Service No. 189

Address 48 Cary Avenue

Location 48 Cary Avenue

Kind of Pipe

Size

Size of Main

~~Repair-Renewal~~ New Service

W.O.# 8320

Location

Comm 5-18-64

Date	Material	Amount	Total	Date	Amount
10/-/63	22.4' 6" A.C.			11-18-63	Deposit 250 00
	installed by contractor			6-9-64	Paid 19 51
	@ 6.00 per foot	134 40	134 40		269 51
	BILL WHEN CONNECTED			10- - 63	
12/9/63	Labor 56.05			224-6" A.C.	
5/1/64	" 19.06	75 11			
	10% O.H.	7 51	82 62		
	27' 6" Transite pipe @.82		22 14		
	1 11 1/4" Transite Elbow		2 35		
	2 Hrs. Town Shovel @6.50		13 00		
	2 Hrs. Trucking @3.00		6 00		
	3 Yds. Loam @3.00		9 00		
			269 51		


DATE _____

TOWN OF LEXINGTON — BOARD OF PUBLIC WORKS

SEWER DIVISION

Sketch of Service Here

48

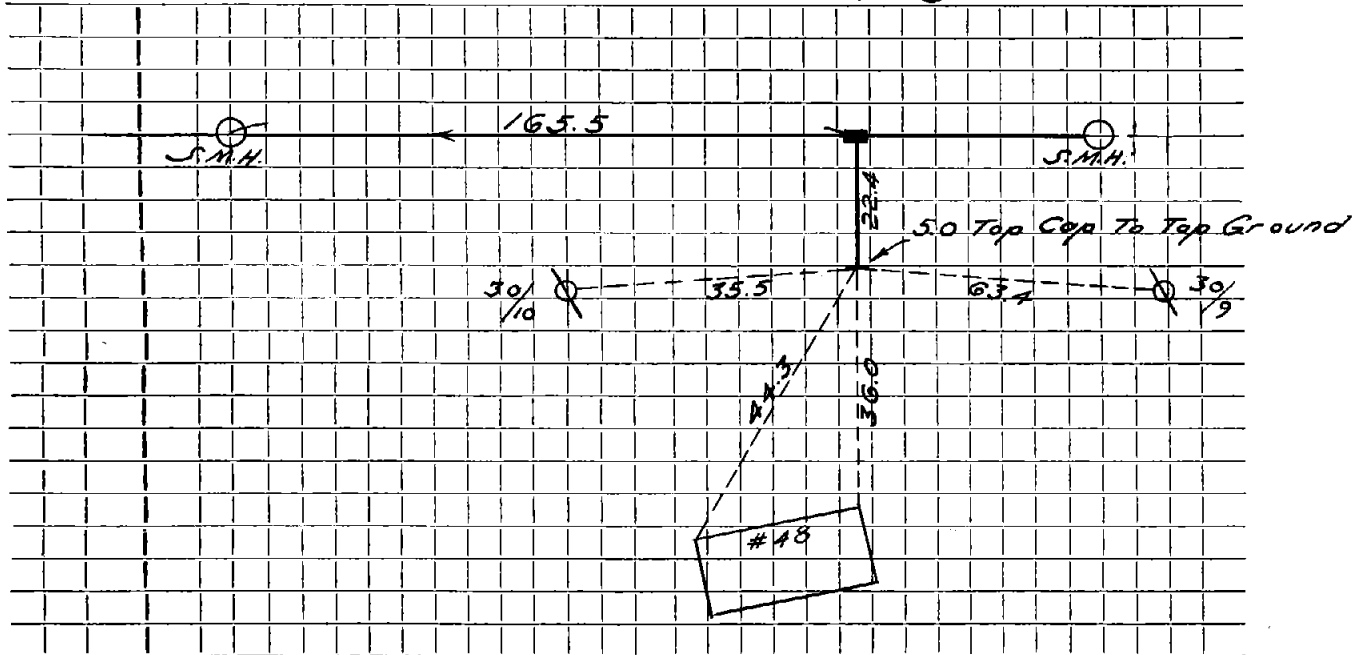

Connection made in Street. Work completed

Remarks:
.....
.....