


DATE 8-15-01

TOWN OF LEXINGTON — BOARD OF PUBLIC WORKS
SEWER DIVISION

Sketch of Service Here

49 CARY AVE

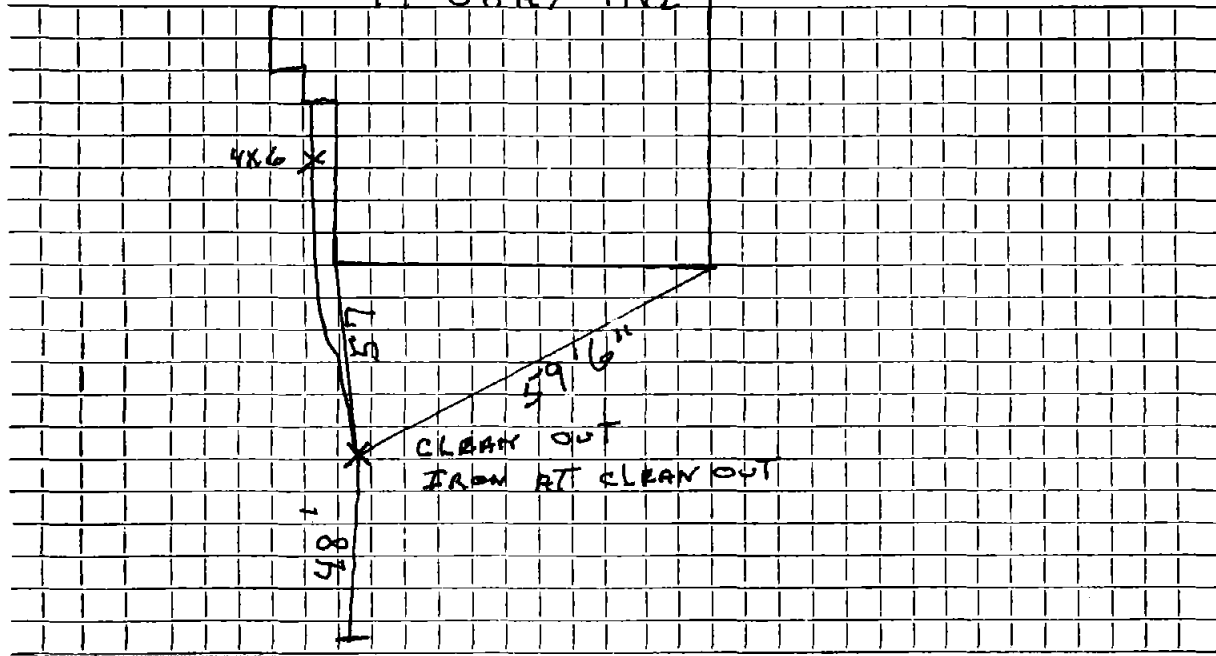

Connection made in ... CARY... AVE ... Street. Work completed ... 4-20-01

Remarks: INSTALLED BY "ON THE LEVEL"