




DATE 10-1-1999

TOWN OF LEXINGTON — BOARD OF PUBLIC WORKS  
SEWER DIVISION

Sketch of Service Here

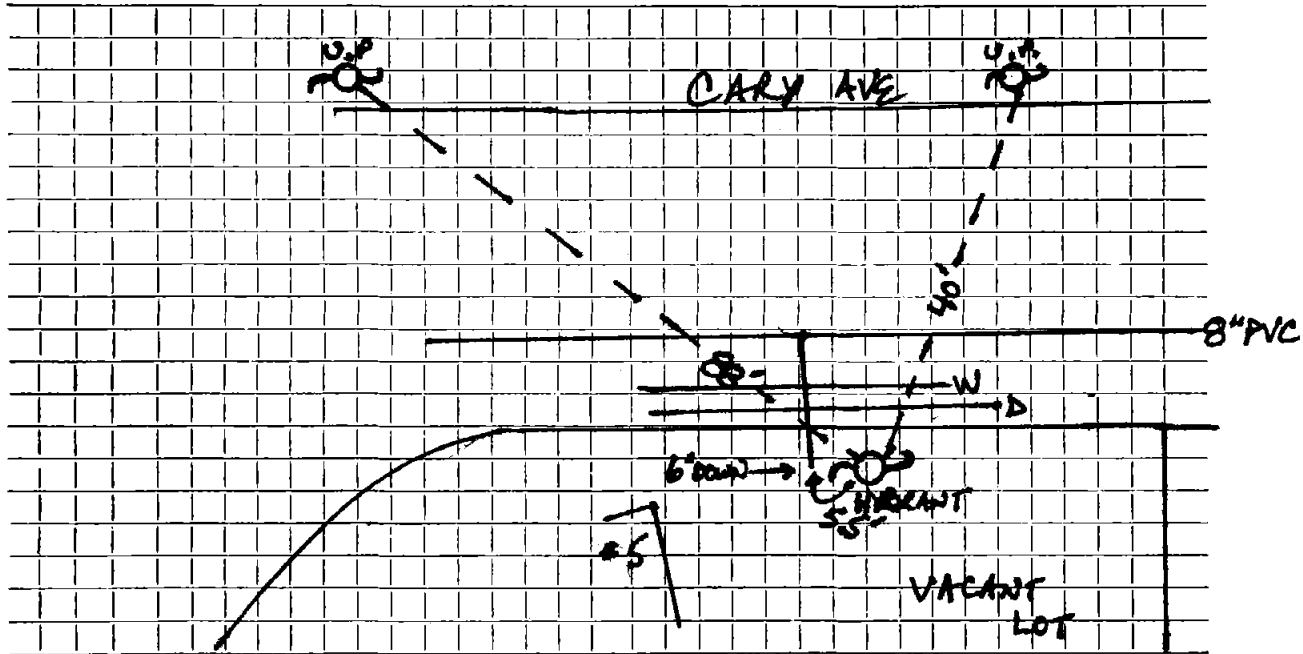

Connection made in ..... Street. Work completed .....

Remarks: SMB END 6\" DOWN

SEWER SERVICE BELOW DRAIN 1'

FIELD BOOK 99-12-1, PG 9

D.F