

Name Frederick Munn

Service No. 190

Address 52 Cary Avenue

Location 52 Cary Avenue

Kind of Pipe

Size

Size of Main

~~Repair General~~ New Service

WCH 8321

Location


Cm m 5-18-64

Date	Material	Amount	Total	Date	Amount
10-1-63	20.0' 6" A.C.			11-18-64	300.00
	installed by contractor			5-18-64	39.50
	@ 6.00 per foot	120.00			262.50
	BILL WHEN CONNECTED			10- -63	
1-8-64	Labor 58.87			20' 6" A.C.	
4-1-64	" 7.15	66.02			
	10% O.H.	6.60	72.62		
	32' 6" Transite pipe @.82		26.24		
	6½ ton 1½" Stone @1.50		9.75		
	1 11¼° Transite bend		4.09		
	1½ yds. Loam @3.00		4.50		
	3 hrs. Town Shovel @6.50		19.50		
	2 hrs. Trucking @3.00		6.00		
			262.70		

DATE _____

TOWN OF LEXINGTON — BOARD OF PUBLIC WORKS
SEWER DIVISION

Sketch of Service Here **52**

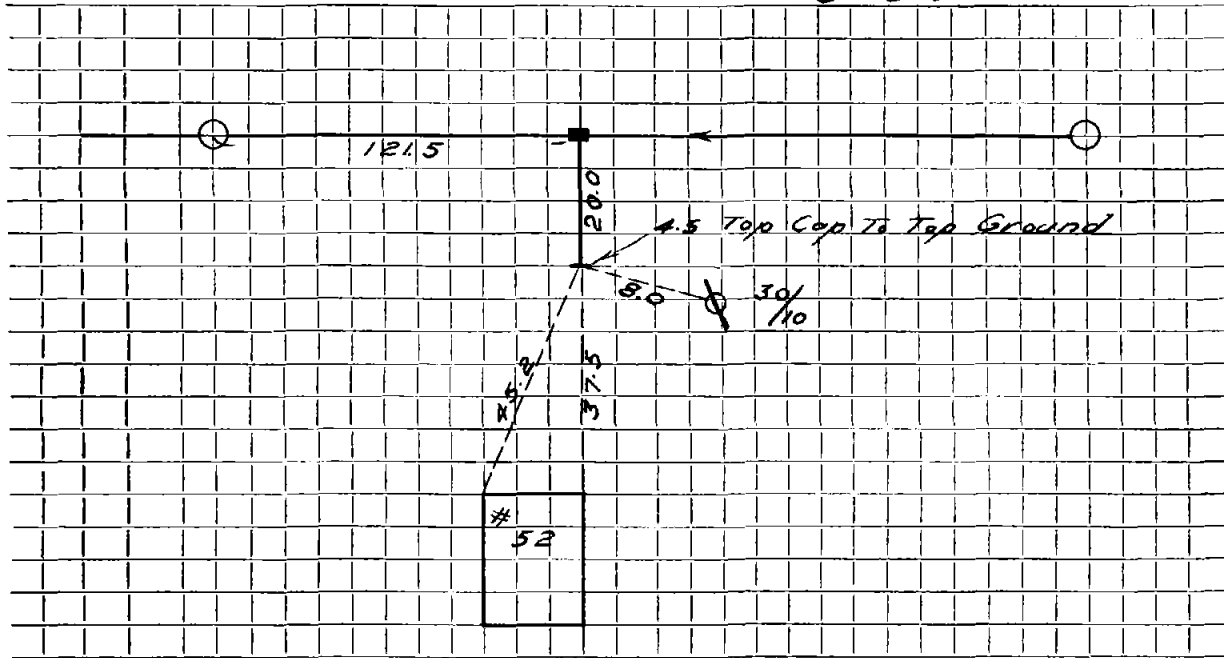

Connection made in Street. Work completed

Remarks:
.....
.....