

Name *Cynthia Barnes*

Service No. 39

Address 53 Cary Avenue

Location 53 Cary Avenue

Kind of Pipe

Size

Size of Main

~~Repair~~ ~~Renewal~~ ~~New Service~~ *valeri #4990*


Location

Date	Material	Amount	Total	Date	Amount
10/1/63	14.2' 6" A.C.			<i>9-11-87</i>	<i>85 20</i>
	installed by contractor				
	@ 6.00 per foot	85 20		<i>10- - 63</i>	
	BILL WHEN CONNECTED			<i>14.2' 6" A.C.</i>	
<i>9/14/87</i>	<i>43' 6" PVC</i>				
	<i>7' 4" Cast Iron</i>				
	<i>AC to PVC Fernco</i>				
	<i>4 x 6 Donut</i>				

DATE _____

TOWN OF LEXINGTON — BOARD OF PUBLIC WORKS
SEWER DIVISION

Sketch of Service Here **53**

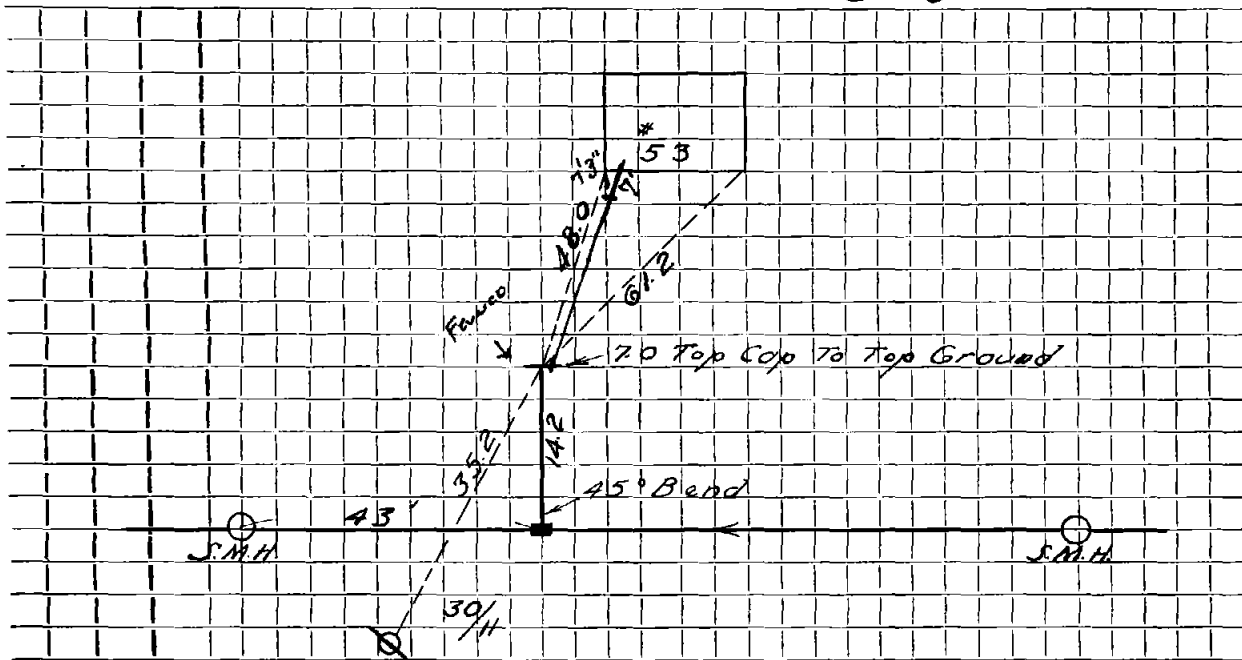

Connection made in Street. Work completed

Remarks:
.....
.....