

Name Joseph W. Moreau

Service No. 204

Address 54 Cary Avenue

Location 54 Cary Avenue

Kind of Pipe

Size

Size of Main

~~Repair & Renewal~~ - New Service

WA# 8353

Location

Comm 518-64


Date	Material	Amount	Total	Date	Amount
10-1-63	22.2' 6" A.C.			11-29-63	300 00
	installed by contractor			5-18-64	28 73
	@ 6.00 per foot	133 20	133 20		271 27
	BILL WHEN CONNECTED			10- - 63	
12-9-63	Labor 56.05			22.2'	6" A.C.
4-30-64	" 12.46	68 51			
	10% O.H.	6 85	75 36		
	24' 6" Transite pipe @.82		19 68		
	5 tons 3/4" Stone @1.50		7 50		
	2 22 1/2° Transite Bends @4.09		8 18		
	1 11 1/4° Transite Elbow		2 35		
	2 Hrs. Town Shovel @6.50		13 00		
	2 Hrs. Trucking @3.00		6 00		
	2 Yards Loam @3.00		6 00		
			271 27		

DATE _____

TOWN OF LEXINGTON — BOARD OF PUBLIC WORKS
SEWER DIVISION

Sketch of Service Here

54

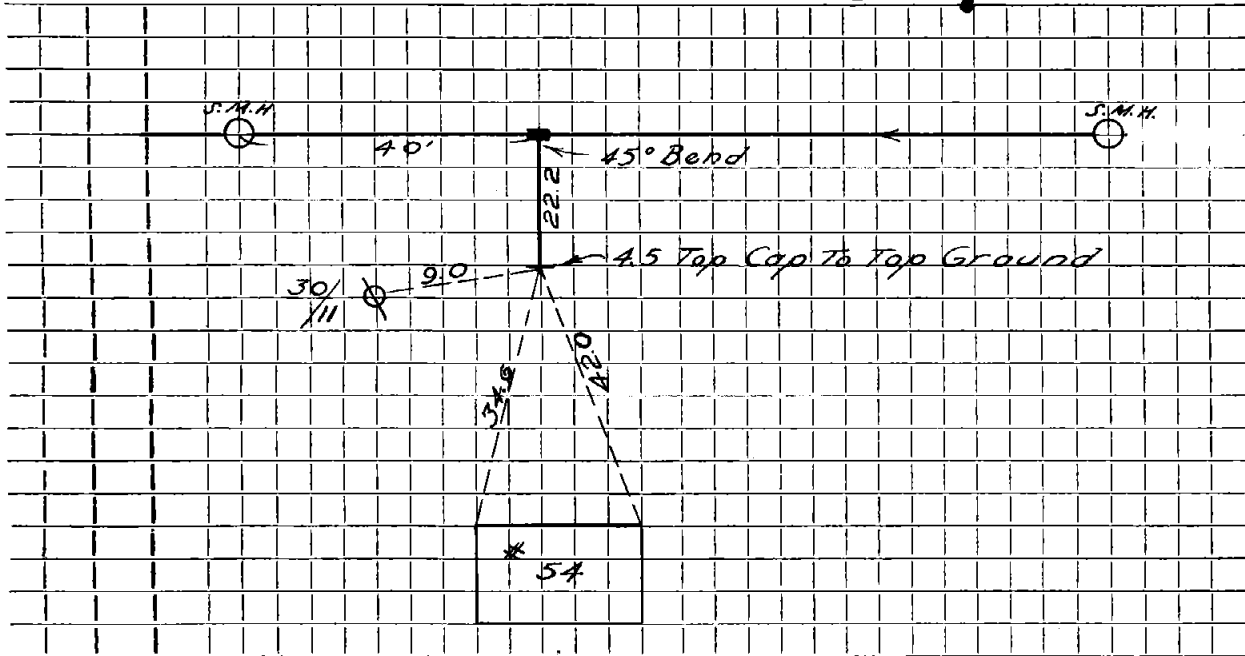

Connection made in Street. Work completed

Remarks:

.....

.....