

Name Monica Costello

Service No. 44

Address 55 Cary Avenue

Location 55 Cary Avenue

Kind of Pipe

Size

Size of Main

~~REPAIR SERVICE~~ New Service 100# 864/1


Location JUN 29 1964

Date	Material	Amount	Total	Date	Amount
10/1/63	17.5' 6" A.C.			4-9-64	306 00
	installed by contractor			4/26/65	34 19
	@ 6.00 per foot	105 00		10- -63	
	BILL WHEN CONNECTED			17.5' - 6" A.C.	
5-26-64	Labor	126.01			
	10% O.H.	12.60	138.61		
	44' 6" Transite pipe @.82		36.08		
	2 22 ¹ / ₂ ° Transite Bends @4.09		8.18		
	1 11 ¹ / ₂ ° Transite Elbow		2.35		
	1 22 ¹ / ₂ ° Transite Elbow		2.35		
	1 6" Adapter		1.62		
	2 yds. Loam @2.00		4.00		
	1 bag Cement		1.50		
	9 x 3 Patch		9.00		
	3 hrs. Town Shovel @6.50		19.50		
	2 hrs. Trucking @3.00		6.00		
			334.19		34 19

DATE _____

TOWN OF LEXINGTON — BOARD OF PUBLIC WORKS
SEWER DIVISION

Sketch of Service Here **55**

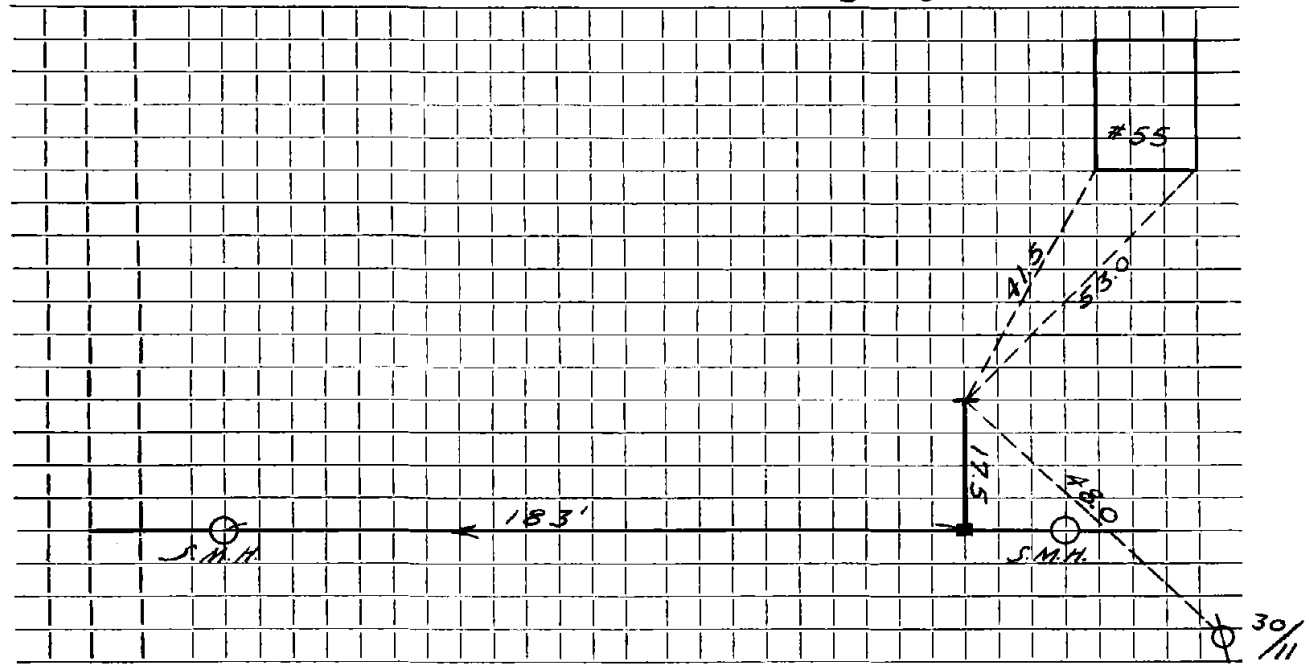

Connection made in Street. Work completed

Remarks:
.....
.....