

Name

Service No.

Address

56 CARY AVE

Location

Kind of Pipe

SDR35

Size

6" PVC

Size of Main

Repair

~~Renewal~~

New Service

Location

Date

Material

Amount

Total

Date

Amount

6/2018

- 6" SDR

"

- CLEAN OUT
· 6" SDR RISER
· 6" PVC CAP
· 6' WYBTEE


"

- 6" x 6" FURNO

DATE 6/2014

TOWN OF LEXINGTON — BOARD OF PUBLIC WORKS
SEWER DIVISION

Sketch of Service Here

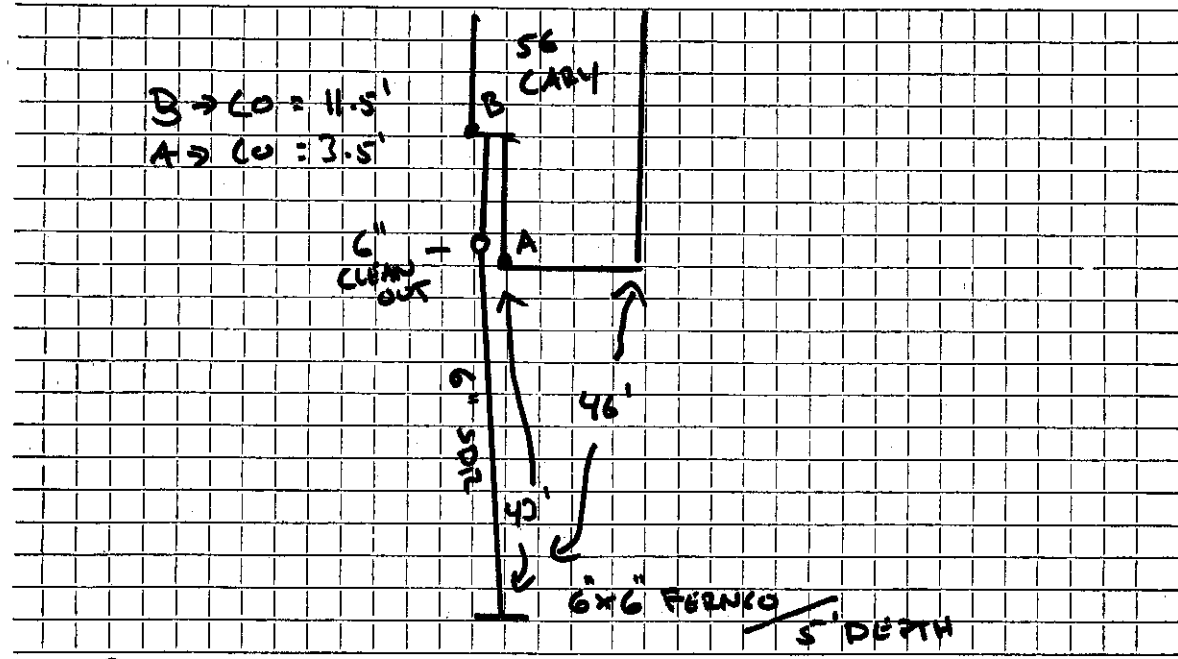

Connection made in CARY Street. Work completed STRONG BACK SYSTEMS

Remarks:

.....

.....