

Name Albert P. Tufts

Service No. 194

Address 59 Cary Avenue

Location 59 Cary Avenue

Kind of Pipe

Size

Size of Main

~~Repair/Reconnect~~ — New Service


Location JUN 29 1964

Date	Material	Amount	Total	Date	Amount
10/1/63	17.3' 6" A.C.			11-26-63	
	installed by contractor			11-26-63	Deposit 300 00
	@ 6.00 per foot	103 80		10-13-64	15 00
	BILL WHEN CONNECTED			10- - 63	294 69
12/5/63	Labor 48.04			173'	6" A.C.
12/6/63	" 56.05	104 09			
	10% O.H.	10 41	114 50		
	35' 6" Transite Pipe @ .82		28 70		
	21 Ton Bank Gravel @ 1.10		23 10		
	53/4 Ton 1 1/2 Stone @ 1.50		8 62		
	7 1/2 Ton Crusher Run @ 1.85		13 88		
	12 2 1/2" Transite Bends		4 09		
	15 X 3 Patch		15 00		
			311 69		

DATE _____

TOWN OF LEXINGTON — BOARD OF PUBLIC WORKS
SEWER DIVISION

Sketch of Service Here **59**

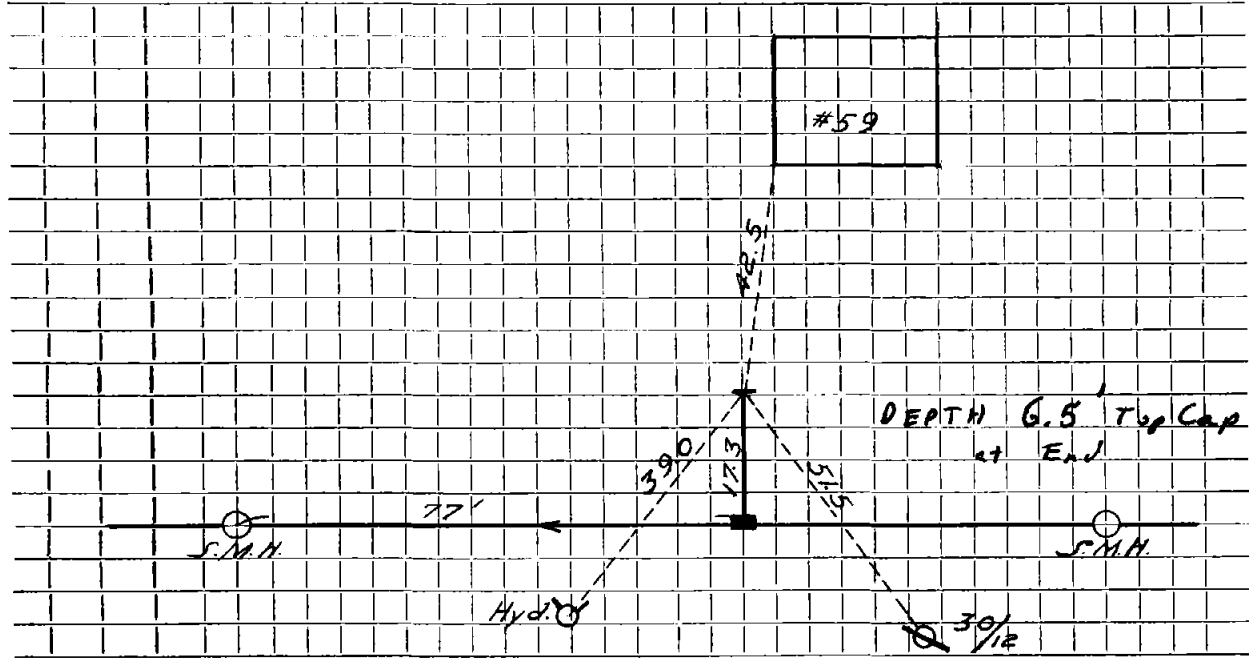

Connection made in Street. Work completed

Remarks:

.....

.....