

Name

Service No.

Address

60 CARRY AVE

GULLAGE

Location

Kind of Pipe

Size

Size of Main

Repair ~~Renewal~~ New Service

Location

Date

Material

Amount

Total

Date

Amount

4/24/18

6" SDR

6" CLEAN OUT

6" PVC CAP

6" SDR RISER

6" TRK WYU


6" x 6" FURNCO



DATE 4/2012

TOWN OF LEXINGTON — BOARD OF PUBLIC WORKS  
SEWER DIVISION

Sketch of Service Here

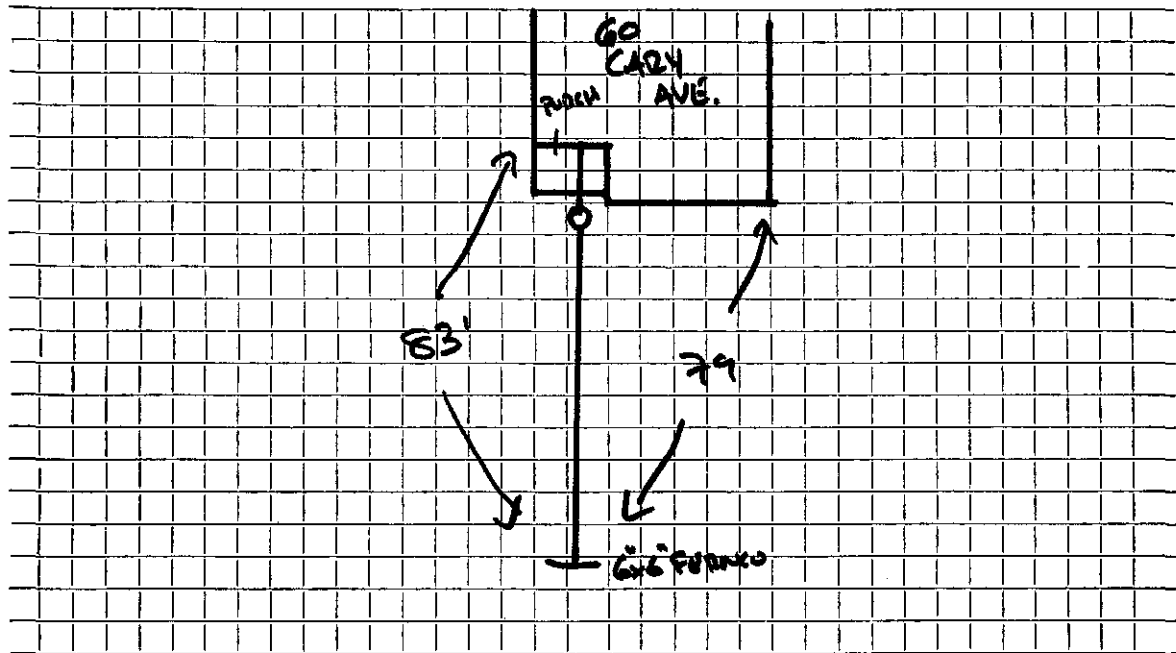

Connection made in CARY Street. Work completed GREG GULLAGHER JR.

Remarks: .....

.....

.....