

Name Carl E. S. Peterson

Service No. 216

Address 62 Cary Avenue

Location 62 Cary Avenue

Kind of Pipe

Size

Size of Main

~~Repair or Extension~~ - New Service

WC # 8368


Location Comm 5-18-64

Date	Material	Amount	Total	Date		Amount
10-1-63	17.2' 6" A.C.			12-1-63	Deposit	280.00
	installed by contractor			7-27-64	A betc loam	3.00
	@ 6.00 per foot	103.20		1964	paid	19.52
	BILL WHEN CONNECTED			10--63		302.52
1-17-64	Labor 94.46			17.2'	6" A.C.	
1-20-64	" 9.26					
4-30-64	" 12.46	116.18				
	10% O.H.	11.62	127.80			
	30' 6" Transite pipe @.82		27.60			
	5 1/2 ton 1 1/2" Stone @1.50		7.87			
	1 bag Cement		1.55			
	3 hrs. Town Shovel @6.50		19.50			
	4 hrs. Trucking @3.00		12.00			
	1 yd. Loam @3.00		3.00			
			302.52			
	A betc loam		3.00			
			299.52			

DATE _____

TOWN OF LEXINGTON — BOARD OF PUBLIC WORKS
SEWER DIVISION

Sketch of Service Here **62**

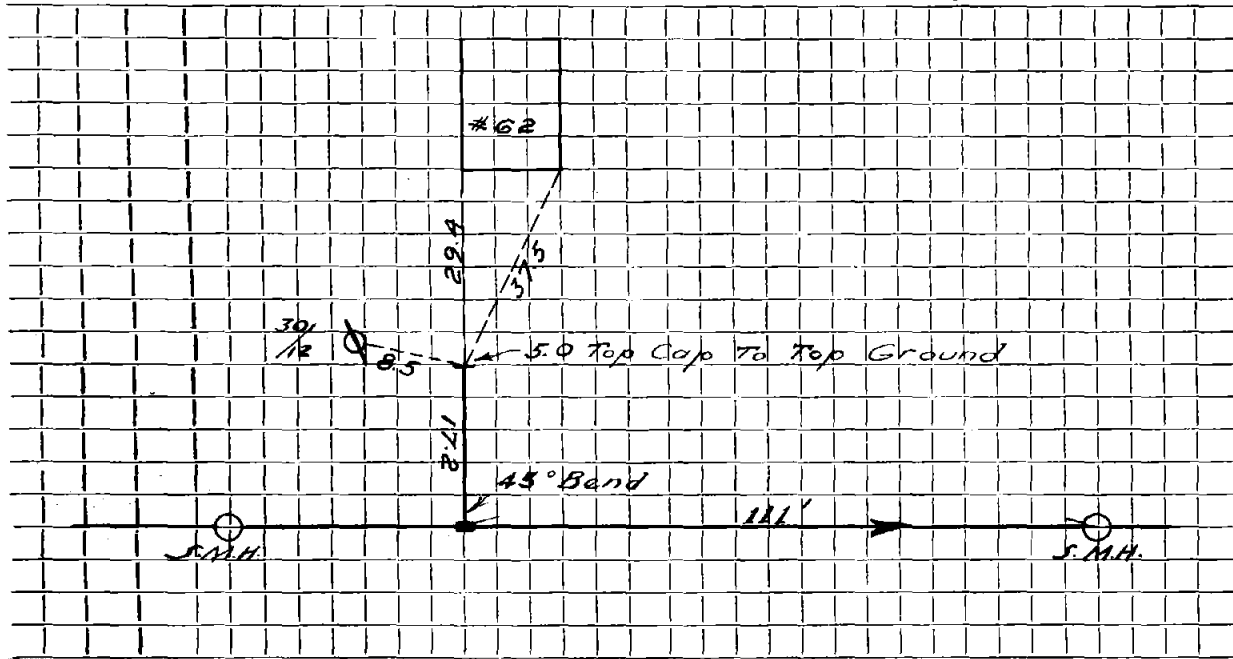

Connection made in Street. Work completed

Remarks:
.....
.....