

Name Philip Spencer

Service No. 94

Address 65 Cary Avenue

Lot #126

Location

Kind of Pipe

Size

Size of Main

~~Repair~~ Renewal — New Service

DeFlice Bros. Permit #18


Location Comm 9-21-64

Date	Material	Amount	Total	Date	Amount	
6-8-64	Labor	107.42		6-4-64	Deposit	100.00
6-9-64	"	18.75	126.17	9-21-64	Paid by WH 56	47.21
	10% O.H.	12.62	138.79	4-29-64	Paid	65.79
	25' 6" Transite pipe @.82		20.50			
	1 bag Cement		1.50			
	1 90° Transite Elbow		4.09			
	24 x 3 Patch		24.00			
	1 6" Duplex Adapter		1.62			
	2 hrs. Town Shovel @6.50		13.00			
	2 hrs. Trucking @3.00		6.00			
	1 hr. Loader @4.00		4.00			
			213.50			
6-19-64	42' 6" Transite pipe				9/23/75 Roots	

DATE _____

TOWN OF LEXINGTON — BOARD OF PUBLIC WORKS
SEWER DIVISION

Sketch of Service Here

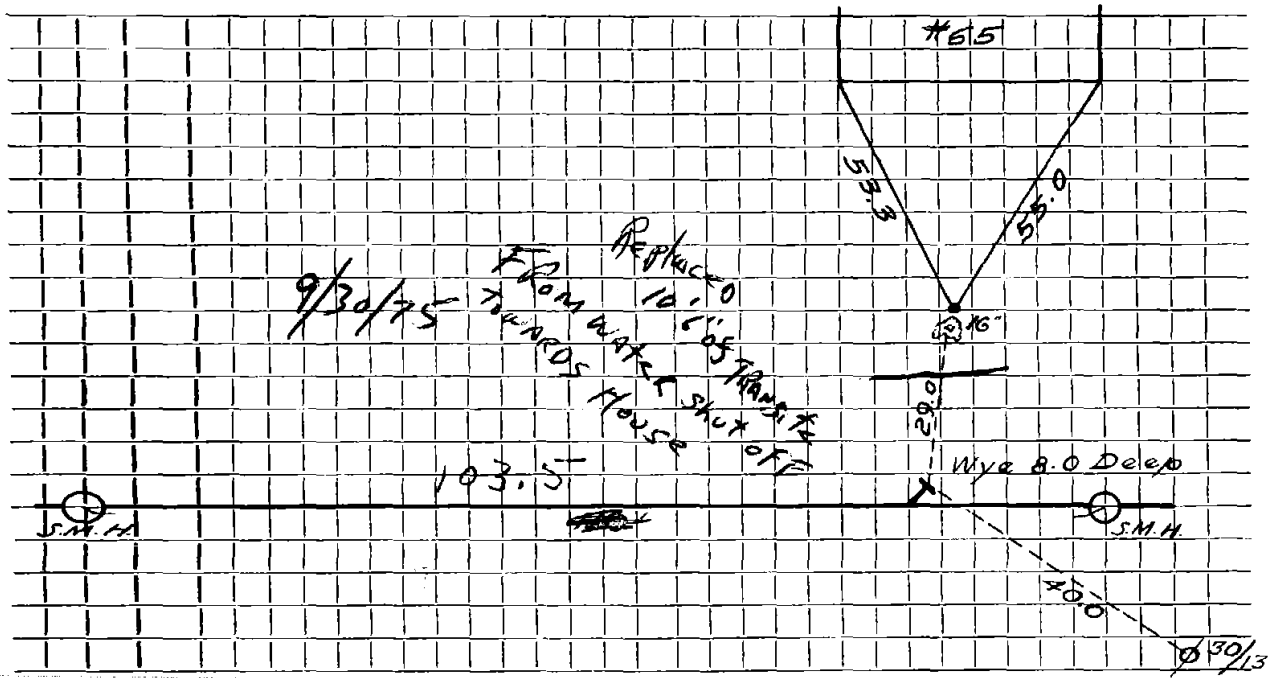

Connection made in Street. Work completed

Remarks:
.....
.....

Name Philip P. Spencer

Service No. 96

Address 65 Cary Avenue

Location

Kind of Pipe

Size

Size of Main

Repair—~~Renewal~~ ~~NEW SERVICE~~ W.O. #3766

Location MAR 15 1976

Date	Material	Amount	Total	Date	Amount
	<u>NON CHARGE</u>			9/24/75	Deposit 100.00
9/30/75	Labor 196.64			3/8/76	Refund 100.00
10/1/75	" 57.42	254.06	254.06		
	5½' 6" Transite pipe @1.48		8.14		
	1 6" Transite Nipple		7.80		
	1 8" x 6" Dresser Clamp		34.43		
	1½ ton ¾" stone @3.50		5.25		
	3 yds. Loam @6.00		18.00		
	10 lbs. grass seed @.35		3.50		
	3 hrs. Trucking @ 3.00		9.00		
	3 hrs. Town Shovel @6.50		19.50		
	1 hr. Loader @4.00		4.00		
			363.68		

DATE _____

TOWN OF LEXINGTON — BOARD OF PUBLIC WORKS

SEWER DIVISION

Sketch of Service Here

A large rectangular area filled with a grid of small squares, intended for sketching or drawing technical details related to sewer service.

Connection made in Street. Work completed

Remarks:
.....
.....

