

Name Robert Ericson

Service No. 191

Address 66 Cary Avenue

Lot#117

Location

Kind of Pipe

Size

Size of Main

Repair—Renewal—New Service

WO # 8322

Location

MAR 23 1964


| Date    | Material                                       | Amount | Total  | Date     |                     | Amount |
|---------|--|--------|--------|----------|---------------------|--------|
| 12/4/63 | Labor  | 99 81  |        | 11-18-63 | Deposit             | 200 00 |
| 12/5/63 | Labor  | 56 05  |        | 3-23-64  | Paid by W.H.C. #732 | 49 76  |
|         |  | 155 86 |        | 3-27-64  | Paid                | 13 98  |
|         | 10% Overhead                                   | 15 59  | 171 45 |          |                     | 263 74 |
| 42'     | 6" Transite pipe @                             | 82     | 34 44  |          |                     |        |
| 1       | 22 $\frac{1}{2}$ " <sup>o</sup> Transite Elbow |        | 2 35   |          |                     |        |
|         | 8 x 3 Patch                                    |        | 8 00   |          |                     |        |
| 5       | hrs. Town shovel @ 6.50                        |        | 32 50  |          |                     |        |
| 4       | hrs. Trucking @ 3.00                           |        | 12 00  |          |                     |        |
| 1       | hr. Trailer                                    |        | 3 00   |          |                     |        |
|         |  |        | 263 74 |          |                     |        |

DATE \_\_\_\_\_

# TOWN OF LEXINGTON — BOARD OF PUBLIC WORKS

## SEWER DIVISION

Sketch of Service Here

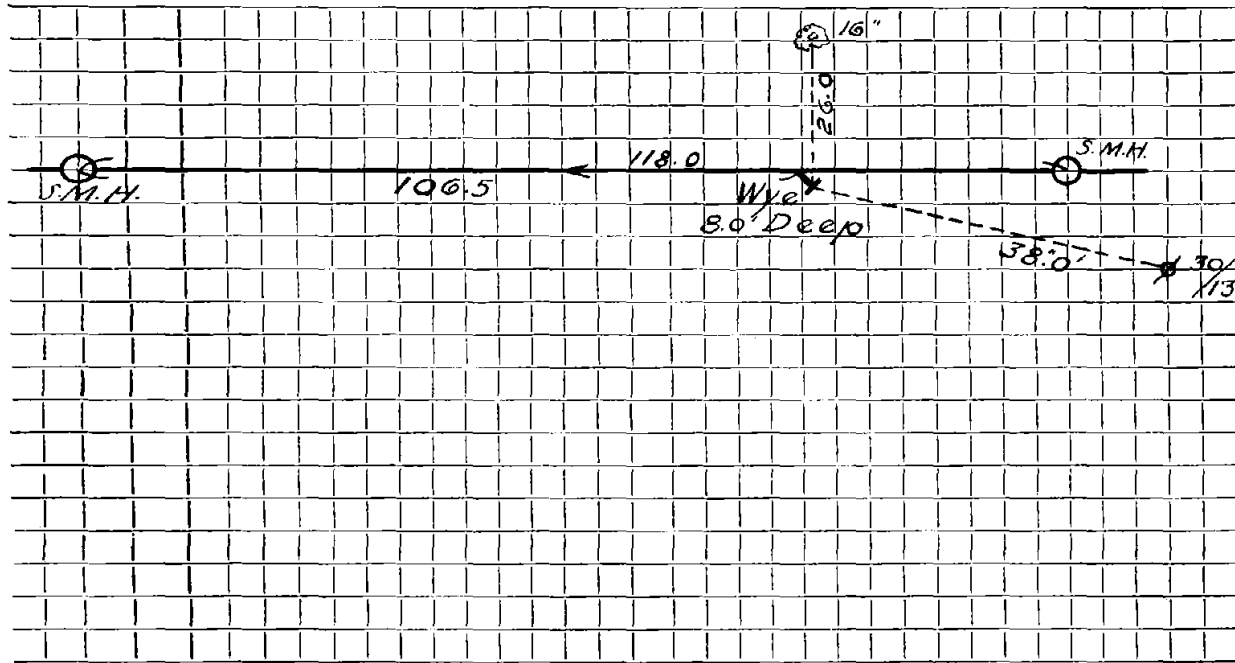

Connection made in ..... Street. Work completed .....


Remarks: .....  
.....  
.....



DATE 25 JUNE 1996

TOWN OF LEXINGTON — BOARD OF PUBLIC WORKS  
SEWER DIVISION

Sketch of Service Here **66**

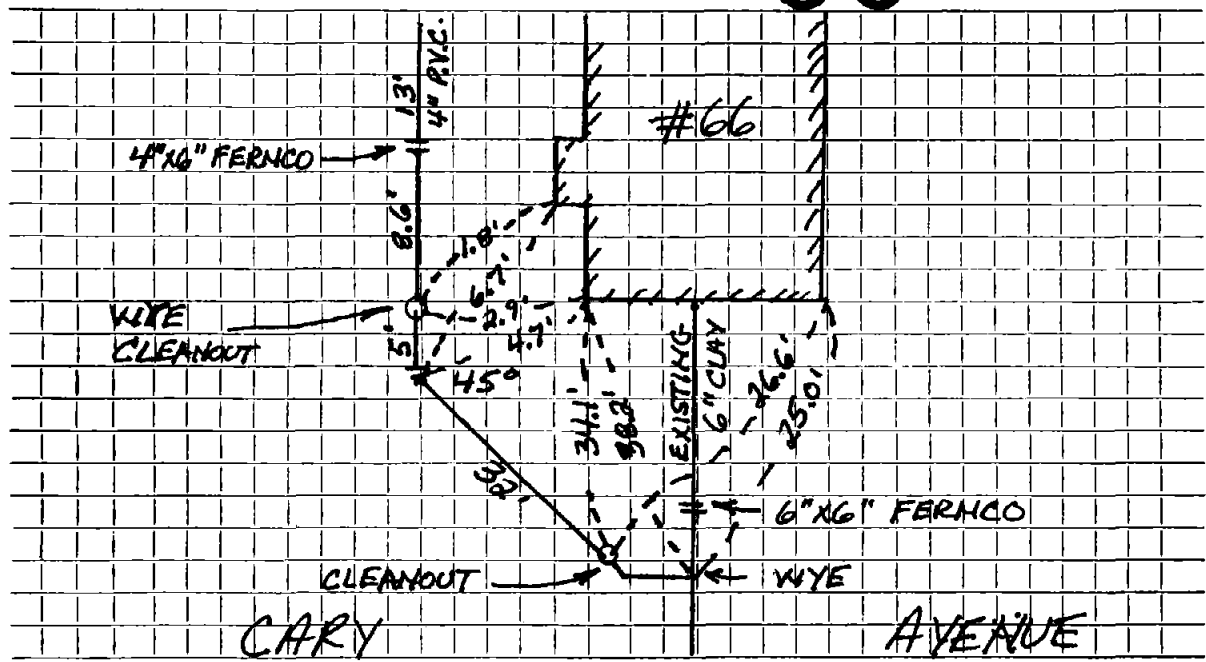

Connection made in CARY AVENUE Street. Work completed MCIVER BROS.

Remarks: .....

BOOK 96-3

J.W.