

Name Charles Sweeney

Service No. 82

Address 72 Cary Avenue

Location 72 Cary Avenue

Kind of Pipe

Size

Size of Main

~~Repair or Renewal~~ — New Service

W.C.# 8742

Location

Comm 9-21-64

Date	Material	Amount	Total	Date	Amount
6-3-64	Previous Charge Labor	89 95	67 20	5-8-64	300 00
	10% O.H.	9 00	98 95	9-21-64	38 29
	43' 6" Transite pipe @ .82		35 26		261 71
	1 Bag Cement		1 50		
	2 11 1/2" Transite Bends @ 4.09		8 18		
	1 Duplex Adapter		1 62		
	8 Yds Loam @ 3.00		24 00		
	2 Hrs Town Shovel @ 6.50		13 00		
	3 Hrs Trucking @ 3.00		9 00		
	1 Hr Trailer @ 3.00		3 00	10/-/63	
			<u>261 71</u>		11.2 feet 6" A.C. installed by contractor @ 6.00 per foot
					67 20
					BILL WHEN CONNECTED


DATE _____

TOWN OF LEXINGTON — BOARD OF PUBLIC WORKS

SEWER DIVISION

Sketch of Service Here

72

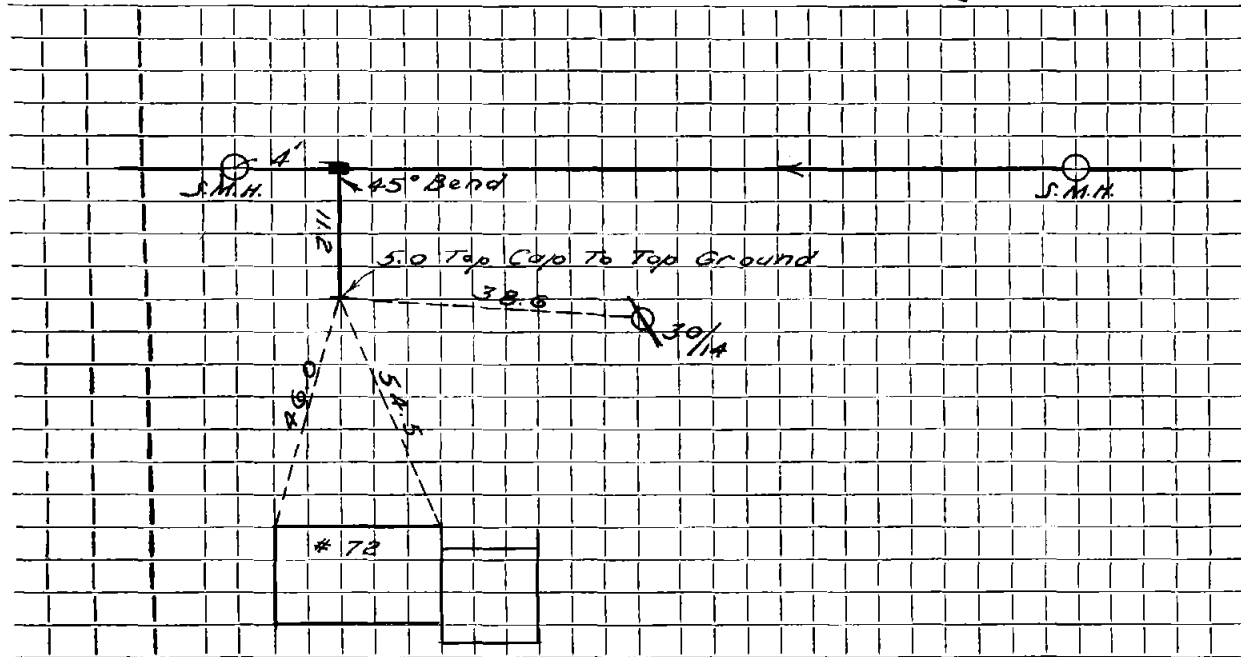

Connection made in Street. Work completed

Remarks:

.....

.....