

Name William Glickman

Service No. 35

Address 76 Cary Avenue

Location 76 Cary Avenue

Kind of Pipe

Size

Size of Main

~~REPAIR EXISTING~~ - New Service *WAF 8612*

Location **JUN 29 1964**

Date	Material	Amount	Total	Date		Amount
4-29-64	Labor	107.99		3-31-64	Deposit	330 00
	10% O.H.	10.80	118.79	6-29-64	Retund	46 01
	50' 6" Transite pipe @.82		41.00			283 99
	8 yds. loam @2.00		16.00			
	6 ton 1 1/2" Stone @1.50		9.00			
	1 bag Cement		1.50			
	3 hrs. Town Shovel @6.50		19.50			
	2 hrs. Trucking @3.00		6.00			
	1 hr. Compressor @5.00		5.00	10/-/63	11.2 feet 6" A.C.	
	Previous Charge		<u>67.20</u>		installed by contractor	
			283.99		@ 6.00 per foot	67 20
					BILL WHEN CONNECTED	


DATE _____

TOWN OF LEXINGTON — BOARD OF PUBLIC WORKS

SEWER DIVISION

Sketch of Service Here

76

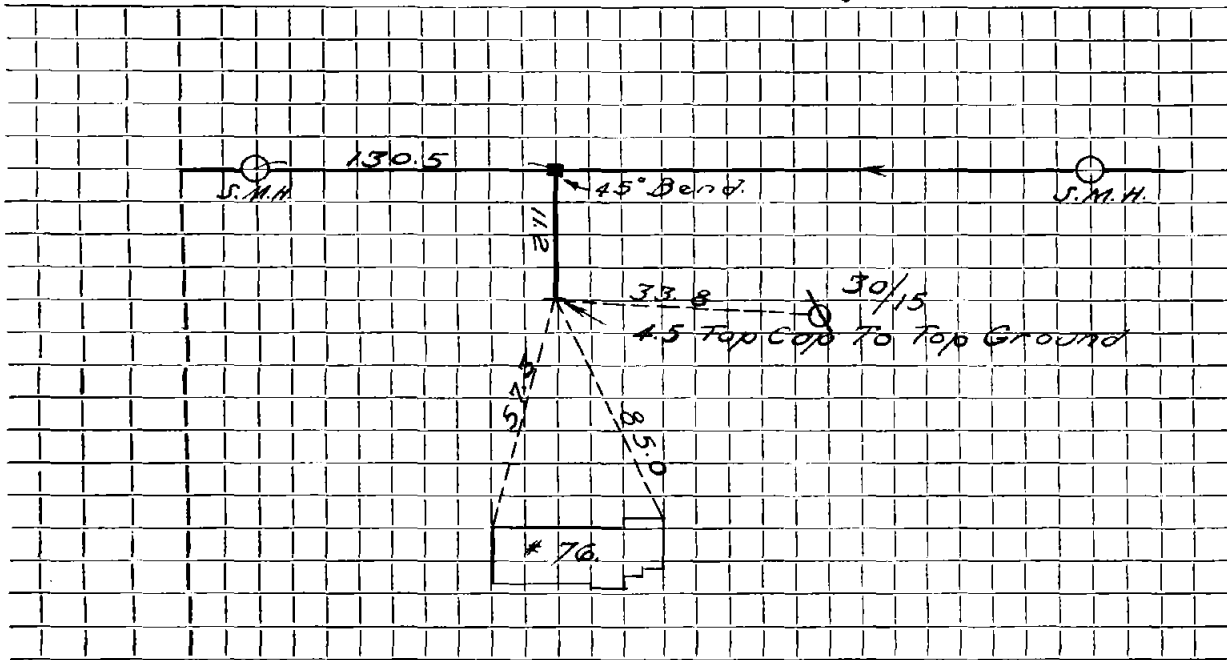

Connection made in Street. Work completed

Remarks:

.....

.....