




DATE 10-1-1999

TOWN OF LEXINGTON — BOARD OF PUBLIC WORKS  
SEWER DIVISION

Sketch of Service Here

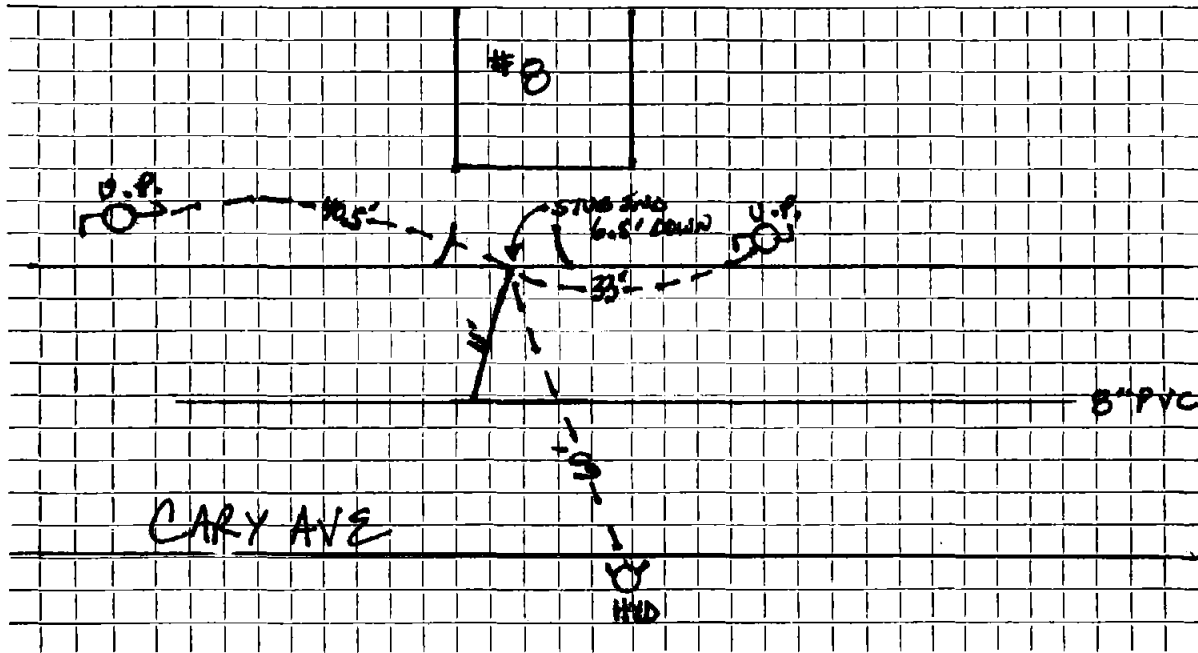

Connection made in ..... Street. Work completed .....

Remarks: SEWER SERVICE INSTALLED TO DRIVEWAY OF #B @ OWNERS REQUEST TO STAY OUT OF DRIVEWAY.

\*WATER SERVICE ABOVE. SEWER ~~SEWER~~ SERVICE ~ 18"

FIELD BOOK 99-12-1, PG. 8, 9

D.F.