

Name Louis A. Holt

Service No. 76

Address 87 Cary Avenue

Location 87 Cary Avenue

Kind of Pipe

Size

Size of Main

~~Repair~~ Renewal—New Service

Wc # 8214

Location

Comm 9-21-64


Date	Material	Amount	Total	Date	Amount
10-1-63	27 5' 6" A.C.			5-4-64	550 00
	installed by contractor			9-21-64	82 30
	@ 6.00 per foot	165 00		10- - 63	467 80
	BILL WHEN CONNECTED			25.7' - 6" A.C.	
6-4-64	Labor	97.50			
6-5-64	"	34.27	131 77		
	10% O.H.	13 18	144 95		
	138' 6" Transite pipe @.82		113 16		
	1 Bag Cement		1 50		
	1 22 $\frac{1}{2}$ " Transite Bend		4 09		
	1 22 $\frac{1}{2}$ " Elbow		2 35		
	3 $\frac{1}{2}$ Hrs Town Shovel @ 6.50		22 75		
	2 Hrs Compressor @ 5.00		10 00		
	1 Hr Loader @ 4.00		4 00		
7-17-91	Renewal		467 80		
	7' 4" PVC				
	1 4" X 6" Fernco				

DATE _____

TOWN OF LEXINGTON — BOARD OF PUBLIC WORKS

SEWER DIVISION

Sketch of Service Here

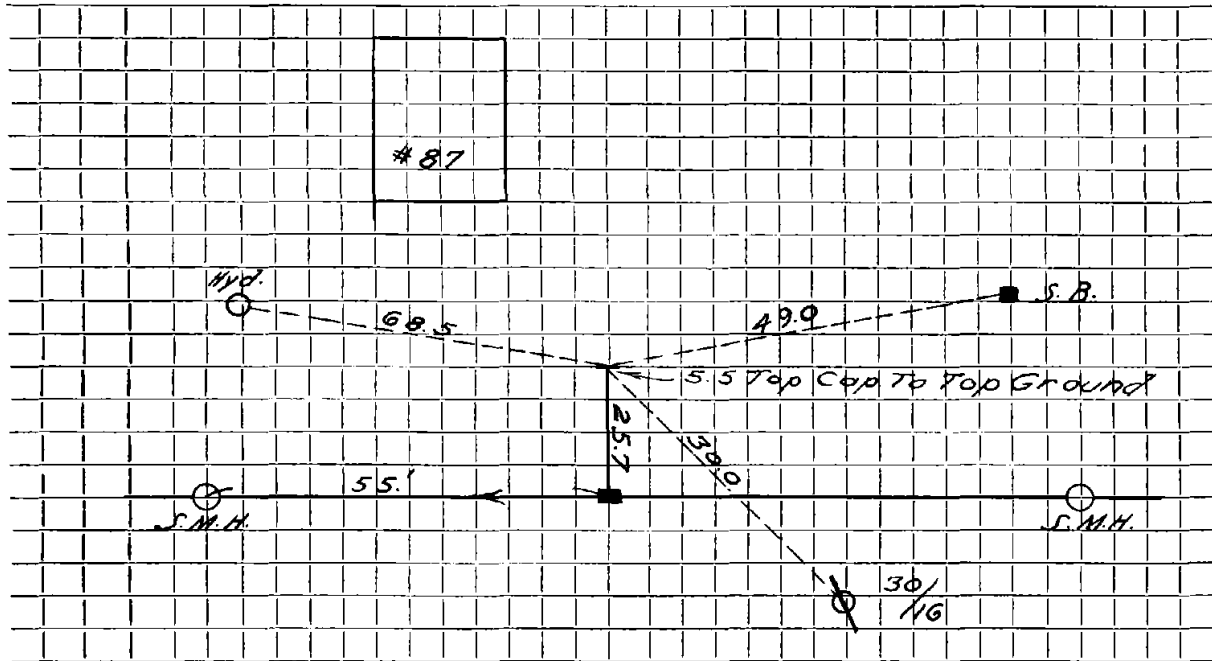

Connection made in Street. Work completed

Remarks:

.....

.....