


DATE _____

TOWN OF LEXINGTON — BOARD OF PUBLIC WORKS
SEWER DIVISION

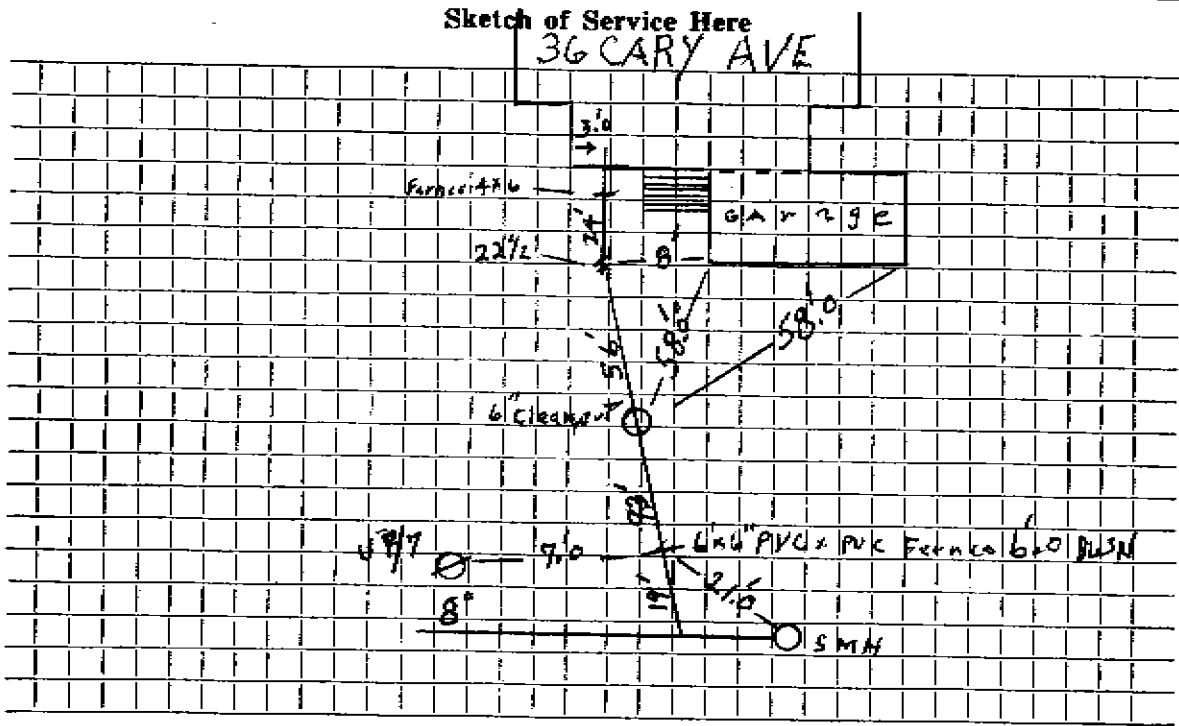

Connection made in Cary Ave Street. Work completed 3/6/09 J. McLaughlin

Remarks:

.....

.....