

Name

Service No. 3097

Address 62 Cary Ave

Location

Lot 5

Kind of Pipe PVC + Clay

Size 6

Size of Main

Repair—Renewal—New Service

J. McLaughlin

Location


Date	Material	Amount	Total	Date	Amount
10/29/08	6'-6" 4" Sch 40 PVC				
	56' 6" PVC				
	1 4x6 Feruco				
	1 6" PVC & AG Feruco				
	1 2 1/2" bend — DWV 6"				
10/63	Existing				
	17' 6" A.C.				
	1 6" 45° bend				

DATE \_\_\_\_\_

TOWN OF LEXINGTON — BOARD OF PUBLIC WORKS

SEWER DIVISION

Sketch of Service Here

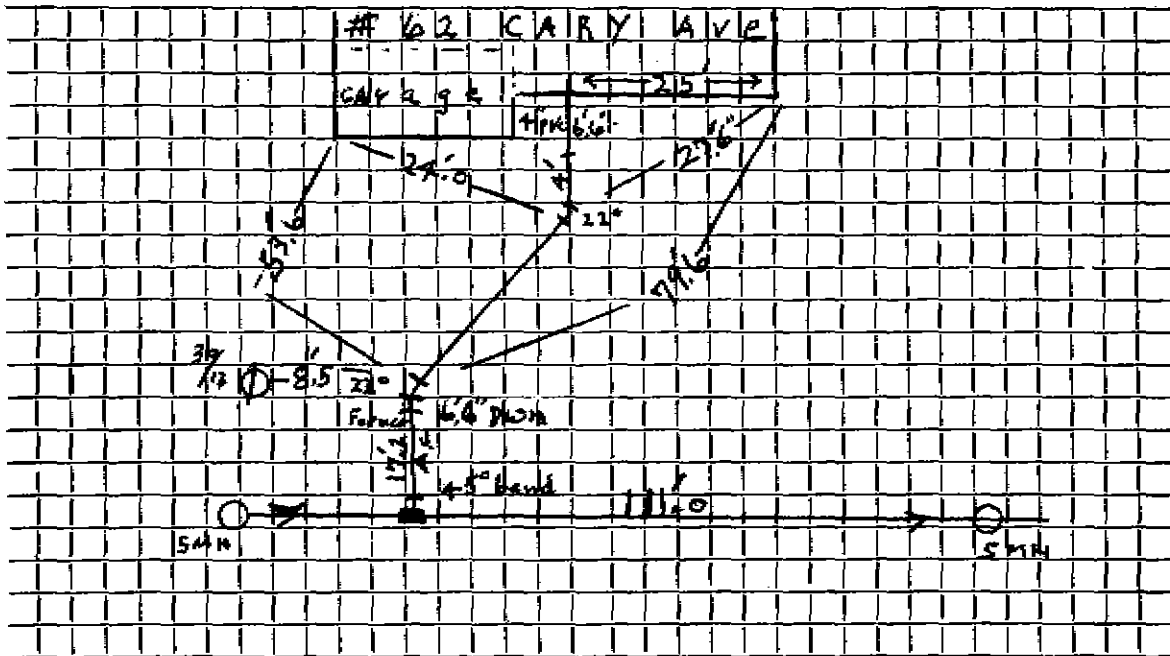

Connection made in \_\_\_\_\_ Street.

Work completed 10/29/08 J. Malsoughlin

Remarks: \_\_\_\_\_  
\_\_\_\_\_  
\_\_\_\_\_