

Name

Service No.

Address 6 Castle Road

Location

Kind of Pipe

Size

Size of Main

Repair—Renewal—New Service

Location


Date	Material	Amount	Total	Date	Amount
7-30-54				5-23-78	
	54' 6" Sewer Pipe				10' 6" Transite
10-16-78	RENEWAL				6' 10" Transite
	30' 6" Transite				1 6" X 8" C.I. Saddle
	1 4" X 6" DONUT				2 5' X 6" Transite Nipple
					1 3' X 6" Transite Nipple
					2 6" X 6" Transite Nipple
					1 6" - 30° Transite Elbow
					1 6" - 30° Transite Bend
					1 6" X 6" Wye
					1 6" - 22½° Transite Bend
					1 6" Adapter
					1 6" END CAP
				2-4-78	Solids
				11-19-68	Solids
				8-16-68	Solids
				12-14-65	Nothing Plugged Inside
				8-23-65	

DATE _____

TOWN OF LEXINGTON — BOARD OF PUBLIC WORKS
SEWER DIVISION

Sketch of Service Here

6

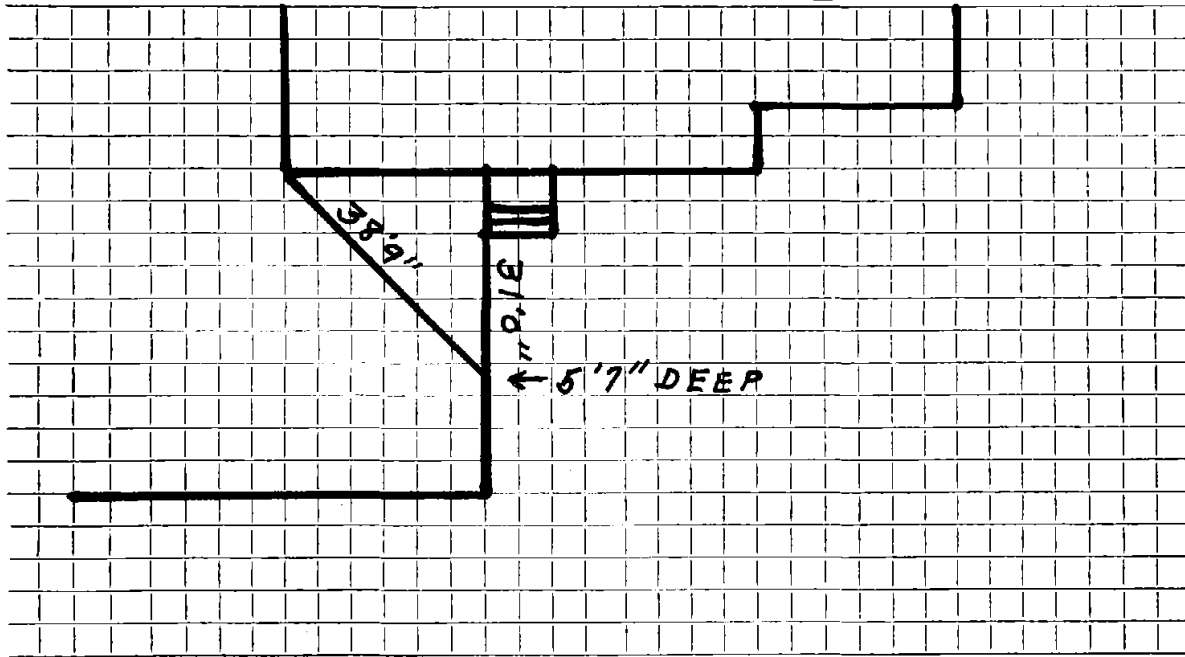

Connection made in Street. Work completed

Remarks:
.....
.....