

Name William Bertozzi

Service No. 162

Address 8 Castle Road

Location

Kind of Pipe

Size

Size of Main

~~Report Renewal~~ New Service W. O. # 222 DePlice #2226

Location FEB 12 1973

Date	Material	Amount	Total	Date	Amount
11/6/72	Labor	140 20		10/27/72	300 00
11/16/	"	46.87		2/12/73	11 97
	10% O.H.	18 71	205 78		288 03
	30' 6" Transite pipe .90		27 00		
	2½ Ton Patch 8.00		16 00		
	½ Hr. Pick up truck 1.50		75		
	2½ Hrs. Trucking 3.00		7 50		
	3 Hrs. Shovel 6.50		19 50		
	1 Hr. Compressor		5 00		
	½ Hr. Loader 5.00		2 50		
	Roller		2 00		
	Trailer		2 00		
			288 03		
11/7/72	30' 6" Transite				
	10' 4" Cast Iron				


DATE _____

TOWN OF LEXINGTON — BOARD OF PUBLIC WORKS

SEWER DIVISION

Sketch of Service Here

8

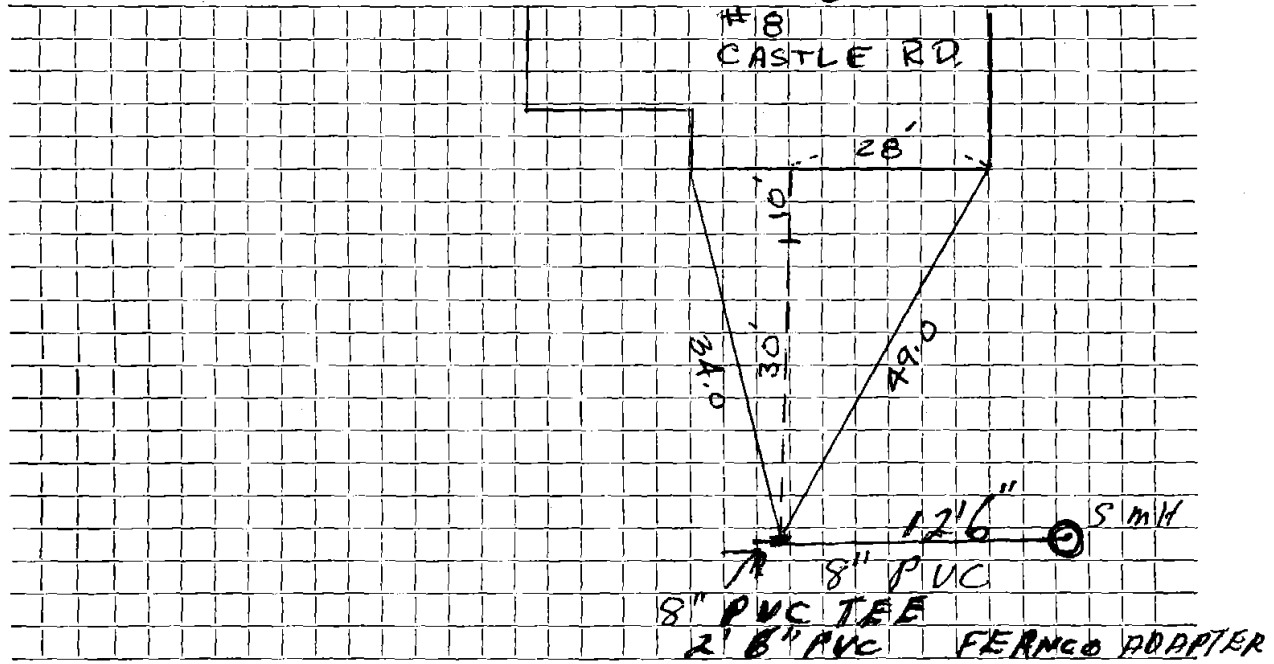

Connection made in Street. Work completed

Remarks:
.....
.....