

Name Earle Phillips

Service No. 6-132

Address 12 Cedar Street

Location 12 Cedar Street

Kind of Pipe

Size

Size of Main

Repair—Renewal—New Service

Location

Date	Material	Amount	Total	Date	Amount
Apr. 25, 44	Labor	19 35		April 26 '44	25 00
26	"	26 45		Feb 28 '46	23 65
27	"	15 30	61 10		98 65
	10% Overhead		6 11		
	Compressor 5 hrs. @ 1.75		8 75		
	Trucking 1 hr @ .75		75		
	31' - 4" Cast Iron		15 50		
	2' - 6" Clay		50		
	1 - 1/4 Bend		67		
	1 - 6"-4" reducer		67		
	Jointing compound		60		
	Patching 2 yds @ 2.00		4 00		
	Labor		98 65		

Hadley Press, Inc., Lexington

TOWN OF LEXINGTON—BOARD OF PUBLIC WORKS
SEWER DIVISION

DATE _____

NO. _____

The undersigned applies for the construction of a particular sewer connecting No. _____ Street and hereby agrees to comply with the Rules and Regulations governing the construction and use of Particular Sewers, as now or at any future time established by the Board of Selectmen.


Am't. of Estimate \$ _____

Am't. Paid \$ _____

_____ Owner

Sketch of Service Here

12

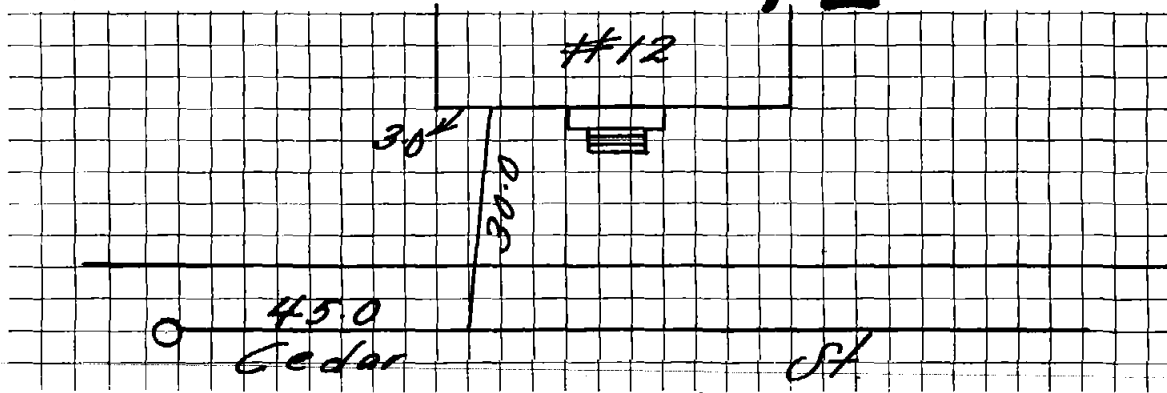

Connection made in _____ Street.

Work completed _____ 19

Remarks: