

Name

Service No.

Address

16 CEDAR ST

Location

Kind of Pipe

SDR 35

Size

6" PVC

Size of Main

Repair

~~Renewal~~

New Service

Location

Date

Material

Amount

Total

Date

Amount

12/2015

6" SDR

35'

4

4" SCH. 40 CLEANOUT, 1
4" PVC CAP
4" PVC RISER
4" TEE + 4"

4

4" x 6" FRP

1

4


6" x 6" FRP

0

DATE 12/2018

TOWN OF LEXINGTON — BOARD OF PUBLIC WORKS
SEWER DIVISION

Sketch of Service Here

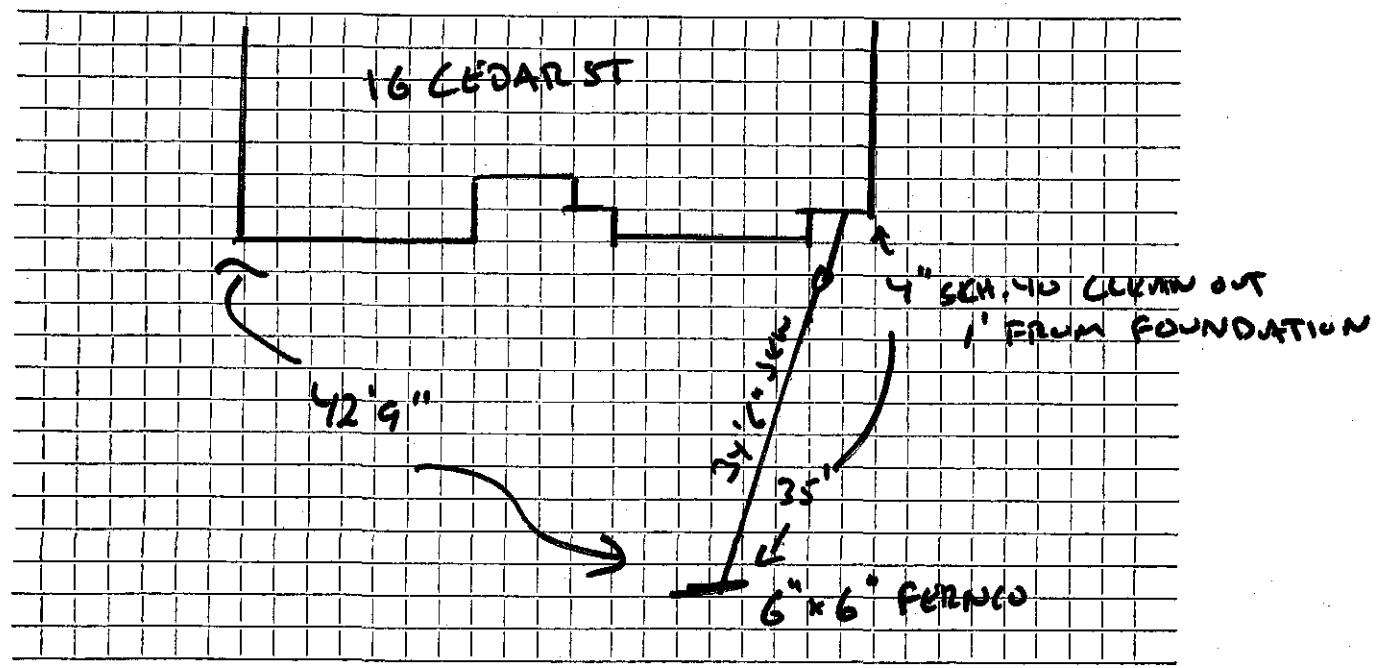

Connection made in ... CEDAR Street. Work completed McLaughlin

Remarks:

.....

.....