

Name George V. Kropps

Service No. 13 134

Address 10 Oakland Street

19 Cedar Street

Location 19 Cedar Street

Kind of Pipe

Size

Size of Main

~~Repair - Renewal~~ - New Service

Location

Date	Material	Amount	Total	Date	Amount
1942					
July 7	28 hrs. @ 60¢	16 80		July 2, 1942 Deposited	85.00
Com 7/24/42	27 " @ 65¢	17 55		Aug 27, 1942 Refund	10.42
	5 " @ 70¢	3 50	37 85		74 58
	10% Overhead		3 79		
	46' 6" Sewer Pipe @ 16¢		7 36		
	5' 4" Soil pipe @ 50¢		2 50		
	1 6" 1/8 Bend		60		
	Jointing compound		2 76		
	3 loads gravel @ 50¢		1 50		
	1 hr. compressor		2 25		
	5 hrs. trucking @ 75¢		3 75		
	Trench repairs		6 22		
	For pumping out cesspool (Canessa)		6 00		
			74 58		
	Labor				

TOWN OF LEXINGTON—BOARD OF PUBLIC WORKS
SEWER DIVISION

DATE _____

NO. _____

The undersigned applies for the construction of a particular sewer connecting No. 19 Cedar St.
Street and hereby agrees to comply with the Rules and Regulations governing the construction and use of Particular
Sewers, as now or at any future time established by the Board of Selectmen.

Am't. of Estimate \$ _____


Am't. Paid \$ _____

Lot.
1324

George V. Kropp Owner
10 Oakland St.

Sketch of Service Here

19

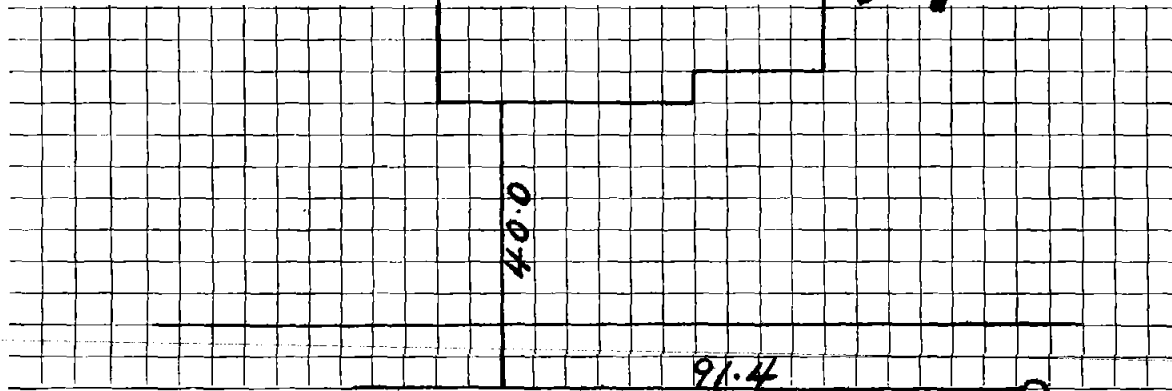

Connection made in _____ Street.

Work completed _____ 19

Remarks: