

Name Mrs. Margaret Kennedy
 Address 20
 12 Cedar St.

Service No. 39 135

Location

Kind of Pipe

Size

Size of Main

~~Repair~~ ~~Renewal~~ - New Service

Pipe inside laid by owner
 Trench " dug by owner

Location

Date	Material	Amount	Total	Date	Amount
12-12-31 for 23.80	18 6" Sewer Pipe @.25 Sulphur & Jute Trucking	4 50 72 75	5 97	Jan. " 1932 - Cash	23 80
11/20/31	26 Hrs. Labor @.55 2 " " @.60 15% Overhead	14 30 1 20	15 50 2 33 23 80		
	Labor			3/11/1970 3/25/71	Solds Prats

Hadley Press, Inc., Lexington

TOWN OF LEXINGTON—BOARD OF PUBLIC WORKS
SEWER DIVISION

DATE _____

NO. _____


The undersigned applies for the construction of a particular sewer connecting No. _____ Street and hereby agrees to comply with the Rules and Regulations governing the construction and use of Particular Sewers, as now or at any future time established by the Board of Selectmen.

Am't. of Estimate \$ _____

Am't. Paid \$ _____

_____ Owner

Sketch of Service Here

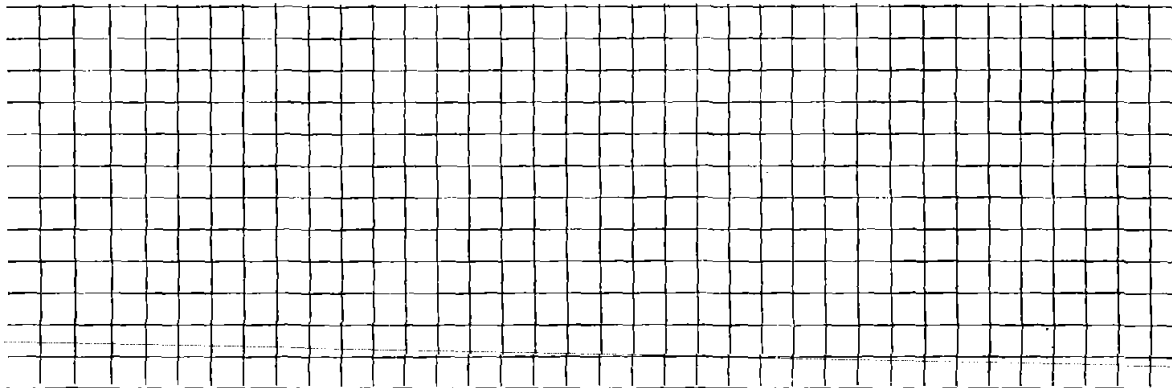

Connection made in _____ Street.

Work completed _____ 19

Remarks: