

Name Thomas Robinson

Service No.

1059

Address 24 Cedar Street

Lexington, Mass.

Location 24 Cedar Street

Kind of Pipe

Size

Size of Main

~~Repair~~ - Renewal - New Service

Location

Date	Material	Amount	Total	Date		Amount
Apr. 8, '47	Labor	38 85		April 7 '47	Deposited	95 00
Apr. 9, '47	"	38 00	76 85	May 24 '47	paid	28 54
	10% Overhead		7 69			12 3 54
	80' - 6" Sewer Pipe @.24		19 20			
	1 - 6" Elbow		1 28			
	1 - 6" Y		1 71			
	Joint Compound		4 80			
	13 lbs. Dynamite @.21		2 73			
	23 Caps @.11		2 53			
	Compressor 3 hrs. @1.75		5 25			
	Trucking 2 hrs. @.75		1 50			
	Labor		123 54			
				11-12-65	Roots	
				12-6-68	Roots	

TOWN OF LEXINGTON—DEPT. OF PUBLIC WORKS
SEWER DIVISION

DATE

NO.

The undersigned applies for the construction of a particular sewer connecting No.
 Street and hereby agrees to comply with the Rules and Regulations governing the construction and use of Particular
 Sewers, as now or at any future time established by the Board of Selectmen.


Am't of estimate \$.....

Am't Paid \$.....

..... Owner

Sketch of Service Here

24

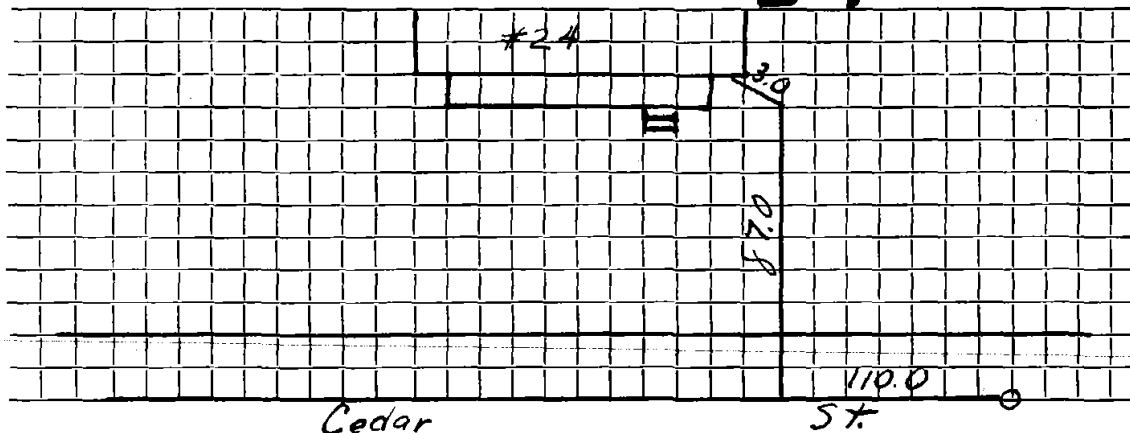

Connection made in Cedar Street.

Work completed 19..

Remarks: