


DATE MAY 9, 1997

TOWN OF LEXINGTON — BOARD OF PUBLIC WORKS
SEWER DIVISION

Sketch of Service Here

32

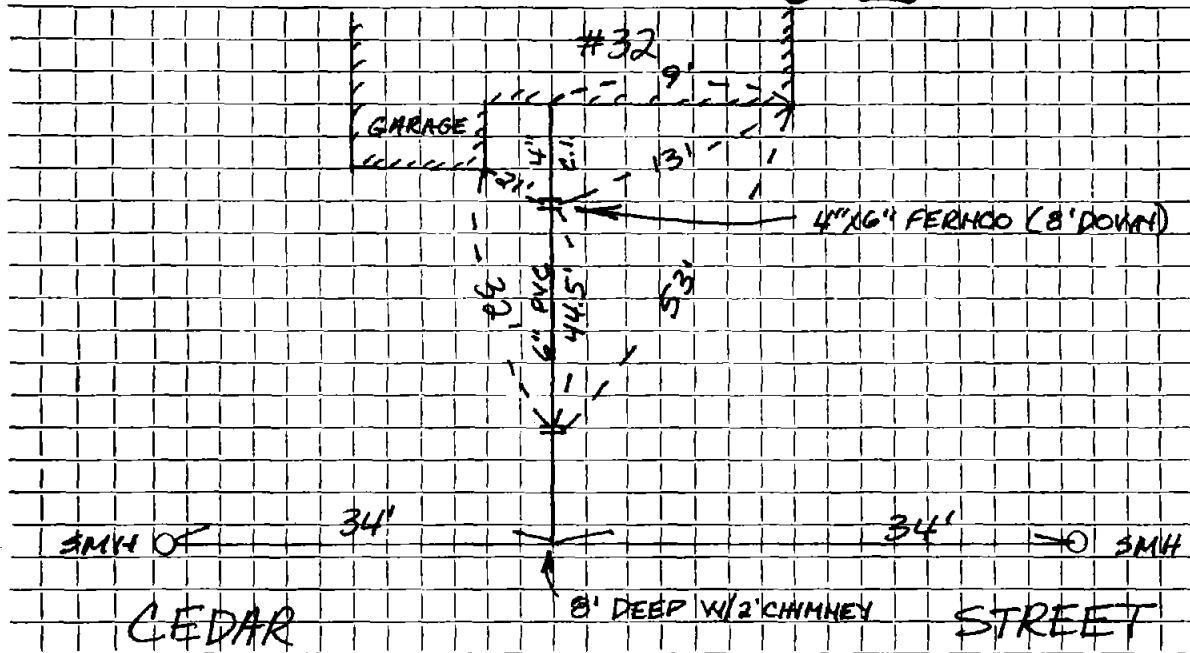

Connection made in CEDAR STREET Street. Work completed

Remarks:

BOOK 97-2

J.W.