

Name Maria Badaracco

Service No. 2

Address 38 Cedar Street

Location

Kind of Pipe

Size

Size of Main

~~Repair~~—Renewal—~~NEW SERVICE~~ W.O. #6082

Location


Date	Material	Amount	Total	Date	Amount
6/16/78	Labor	96.52		2-13-78	Deposit 250.00
	10% O.H.	9.65	106.17		Refund 39.99
10'	6" Transite pipe @1.86		18.60	7-16-78	210.01
1	6" x 3' Nipple		9.36	10'	6" Transite
1	6" x 2' Nipple		6.11	1	6" X 8" Saddle
1	6" x 30° Bend		11.22	1	6" X 6" Transite Nipple
1	6" x 45° Bend		13.50	1	6" - 90° Transite Elbow
1	4" Donut		3.05		
3	yds. Loam @5.44		16.32		
1	bag Lime		1.00		
½	bag Fert.		2.00		
7	lbs. Seed @.74		5.18		
1½	hrs. Trucking @3.00		4.50		
2	hrs. Backhoe @6.50		13.00		
			210.01		
				3-13-78	Roots 12' + 30'
				11-29-67	Roots 12' + 30' Rags + Paper

DATE _____

TOWN OF LEXINGTON — BOARD OF PUBLIC WORKS

SEWER DIVISION

Sketch of Service Here **38**

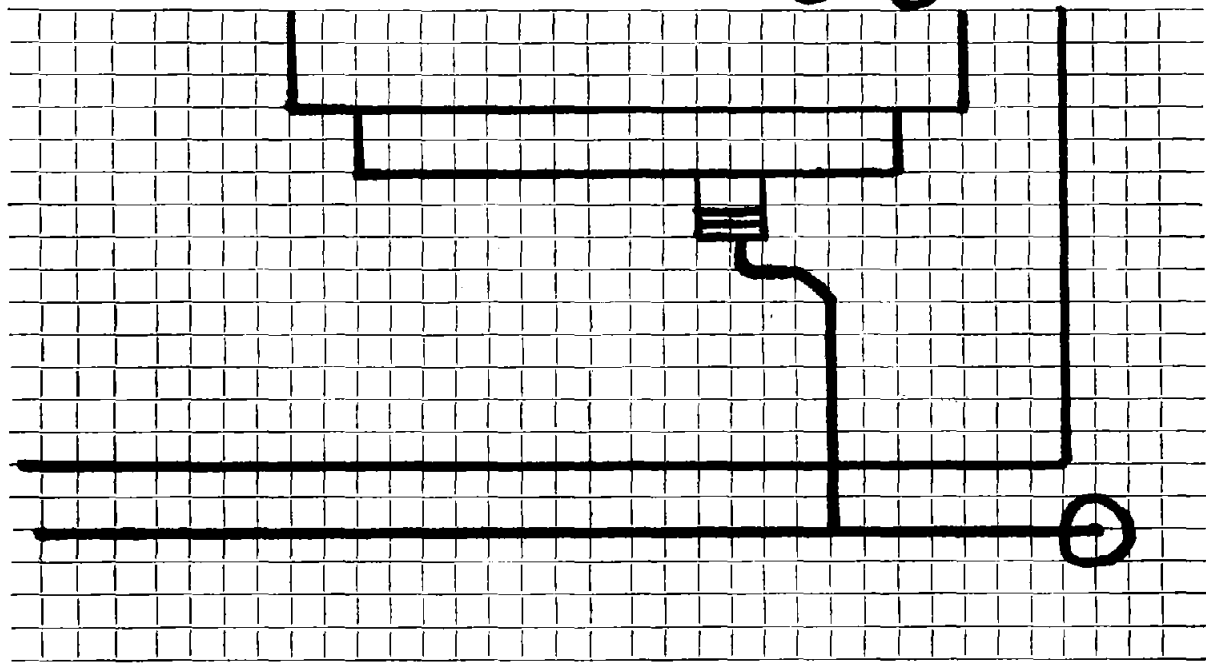

Connection made in Street. Work completed

Remarks: *Original Service 8-22-47*

.....
.....