

Name John A. Buckley

Service No. 17

Address 43 Cedar Street

Location

Kind of Pipe

Size

Size of Main

~~Repair~~ ~~Renew~~ ~~XX~~ - New Service

COM. 6-13-55

Location

Date	Material	Amount	Total	Date	Amount
4/12/55	Labor	21 55		3-11-55	150 00
4/14/55	"	5 05	26 60	6-13-55	(34 22)
	10% overhead		2 66		115 78
	54' - 6" sewer pipe @ .32		17 28		
	joint compound		3 24		
	7 hrs. Littlefield shovel @ 7.50		52 50		
	2 hrs. trucking @ .75		1 50		
	patching 12 x 3		12 00		
			115 78		
	8x6 CI-PVC Furnco			* 25¢ applied to bal. due	
	6x6 CI-PVC " "			on meter comm. #66	
	7'-6" PVC				
	Labor			12/6/79	Bravo/Rocks in 111' &

TOWN OF LEXINGTON—DEPT. OF PUBLIC WORKS

SEWER DIVISION

DATE.....

NO.


The undersigned applies for the construction of a particular sewer connecting No.....
 Street and hereby agrees to comply with the Rules and Regulations governing the construction and use of Particular
 Sewers, as now or at any future time established by the Board of Selectmen.

Am't of estimate \$.....

Am't Paid \$.....

..... Owner

Sketch of Service Here **43**

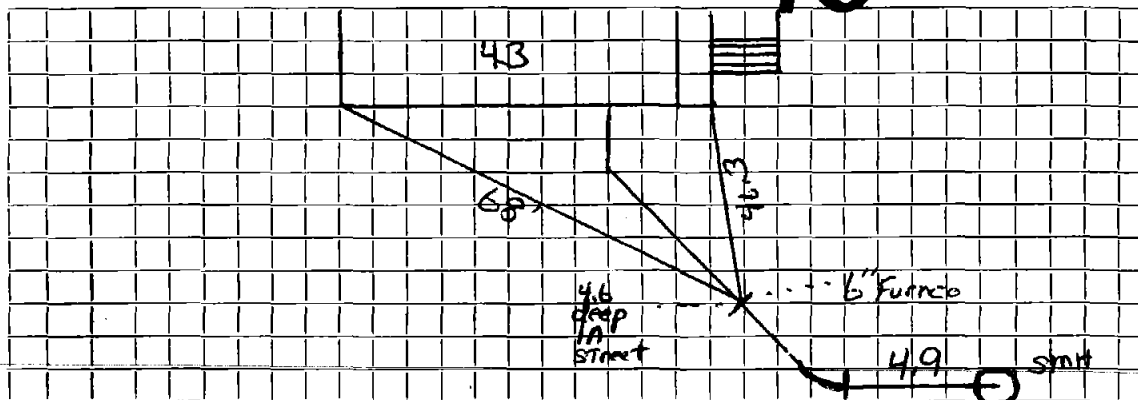

Connection made in Street.

Work completed.....19..

Remarks:
