

Name Homes Realty

Service No.

Address 45 CEDAR ST.

Location

Kind of Pipe

Size

Size of Main

Repair—Renewal—New Service

McLaughlin #0372

Location

Date

Material

Amount

Total

Date

Amount

9/1/94

64 LF 6" PVC

22° ELBOW


4"x6" FRNCO

DATE 9/1/94

TOWN OF LEXINGTON — BOARD OF PUBLIC WORKS  
SEWER DIVISION

Sketch of Service Here

45

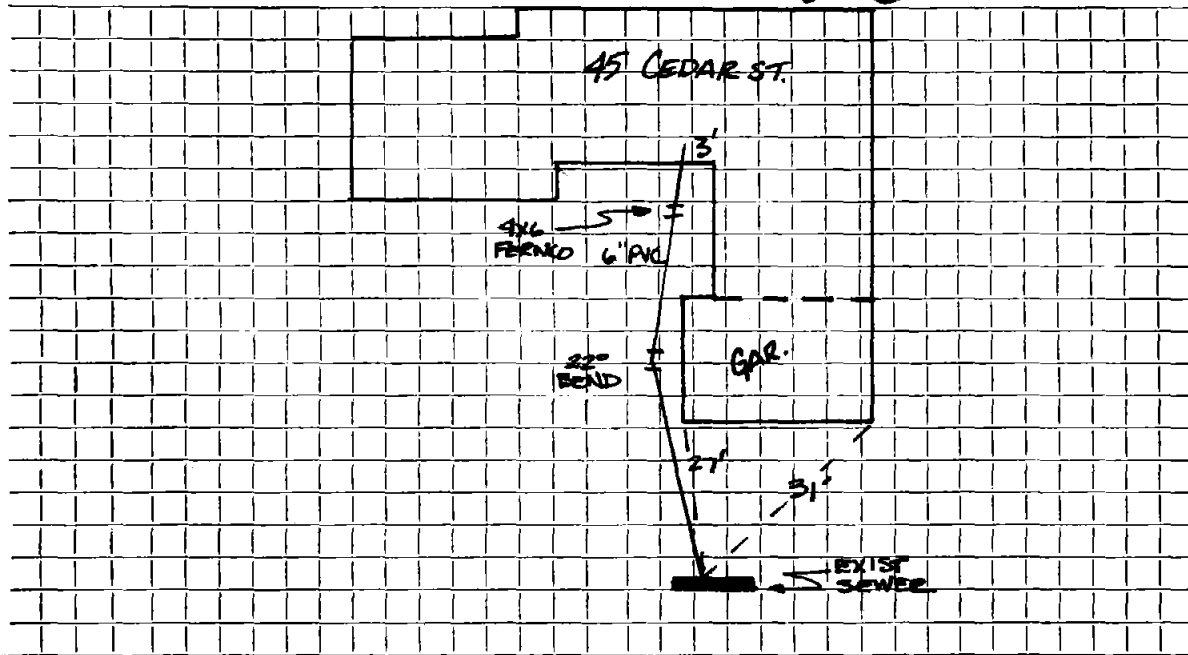

Connection made in ..... Street. Work completed .....

Remarks: Original Service 10-28-58 .....