


DATE 4/3/96

TOWN OF LEXINGTON — BOARD OF PUBLIC WORKS
SEWER DIVISION

Sketch of Service Here **48**

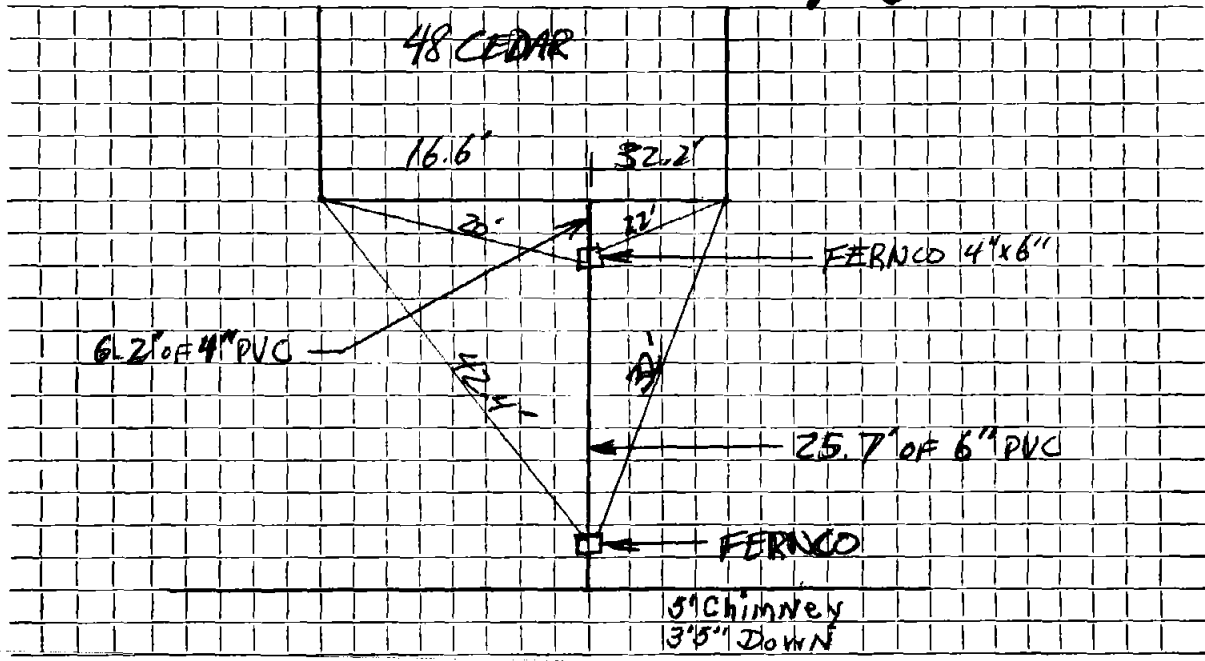

Connection made in Street. Work completed

Remarks: New Service 10-14-75

.....
.....