

Name Robert E. Smith

Service No. 183

Address

Location

Kind of Pipe

Size

Size of Main

~~Repair~~ ~~Renewal~~ New Service

Location

*Com. 11-30-59*

Date	Material	Amount	Total	Date	Amount
9-28-59	Labor	60 42		9-23-59	125 00
	10 $\frac{3}{4}$ O. H.	6 04	66 46	11-30-59	<del>4 95</del>
26'	6" Transite pipe @.70		18 20		120 05
1	6" Transite Elbow 45°		2 79		
1	11 $\frac{1}{4}$ " Transite Bend		5 10		
	8 x 3 Patch		8 00		
4	Hrs. Pippin Shovel @4.50		18 00		
2	Hrs. Trucking @.75		1 50		
			120 05		
	<b>Labor</b>				

**TOWN OF LEXINGTON—DEPT. OF PUBLIC WORKS  
SEWER DIVISION**

DATE.....

NO.....


The undersigned applies for the construction of a particular sewer connecting No.....  
Street and hereby agrees to comply with the Rules and Regulations governing the construction and use of Particular  
Sewers, as now or at any future time established by the Board of Selectmen.

Am't of estimate \$.....

Am't Paid \$.....

..... Owner

Sketch of Service Here **49**

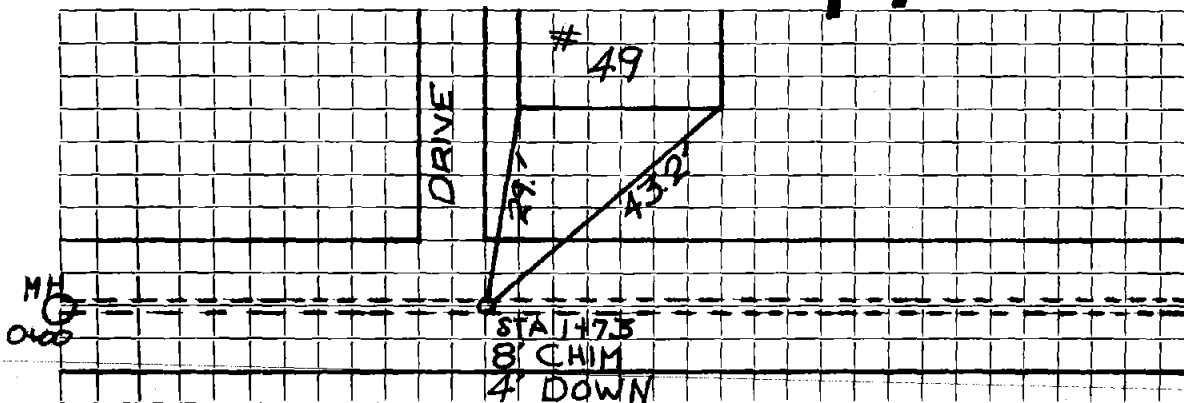

Connection made in..... Street.

Work completed.....19..

Remarks: