

Name Malcolm Graf
 Address 52 Cedar Street

Service No. 22

Location

Kind of Pipe

Size

Size of Main

Repair ~~Renewal~~ New Service W.O. #7664 Valeri #1568

Location SEP 21 1970

Date	Material	Amount	Total	Date	Amount
5/18/70	Labor	102 30		5-1-70	192 00
6/17/70	"	30 55	132 85	12-9-70	32 52
	10% O.H.		13 29		224 52
	20' 6" Transite pipe .90		18 00		
	1 Adaptor		2 00		
	1 6" Nipple		1 20		
	1 90o Elbow		5 65		
	1/2 Bag cement 1.55		78		
	1 Ton Hot top		6 00		
	4 Hrs. Trucking 3.00		12 00		
	3 1/2 " Shovel 6.50		22 75		
	1 " Loader		4 00		
	1/2 " Compressor 5.00		2 50		
	1/2 " Roller 3.00		1 50		
	Trailer		2 00		
6/3/70	136' 6" Transite pipe		224 52		
	5' 4" Cast Iron Pipe				
	5' 3" Cast Iron pipe				


I.B.N. 18501

DATE _____

TOWN OF LEXINGTON — BOARD OF PUBLIC WORKS
SEWER DIVISION

Sketch of Service Here

52

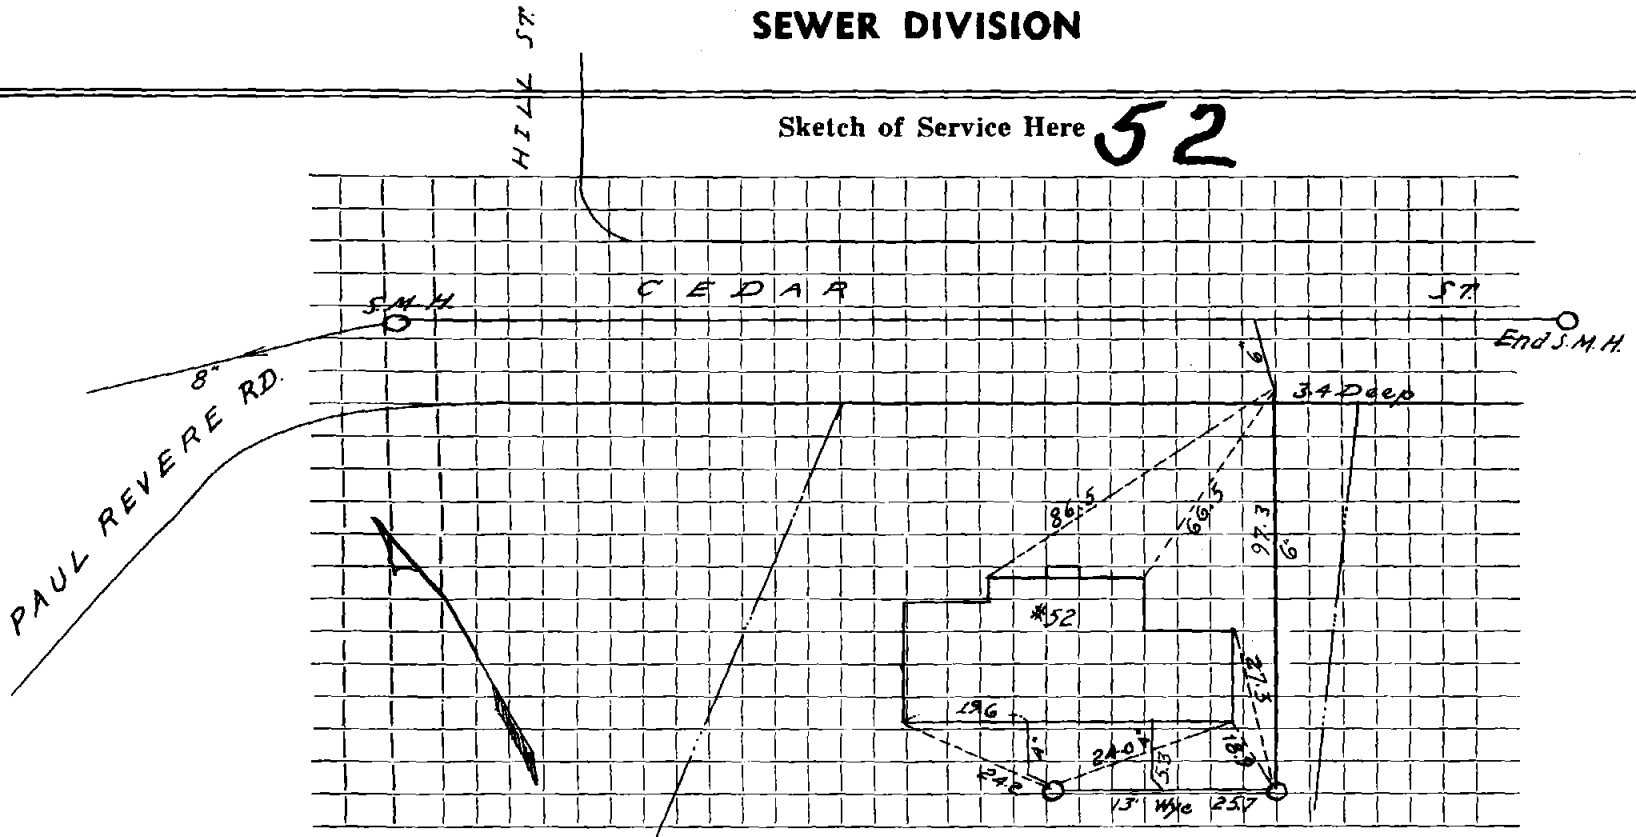

Connection made in Street. Work completed

Remarks:

.....

.....