

Name Virginia M. Powers

Service No. 280 C1960

Address 66 Cedar Street

Location

Kind of Pipe

Size

Size of Main

~~Repair~~ ~~Renewal~~ ~~New Service~~

Location

Comm 9-25-61

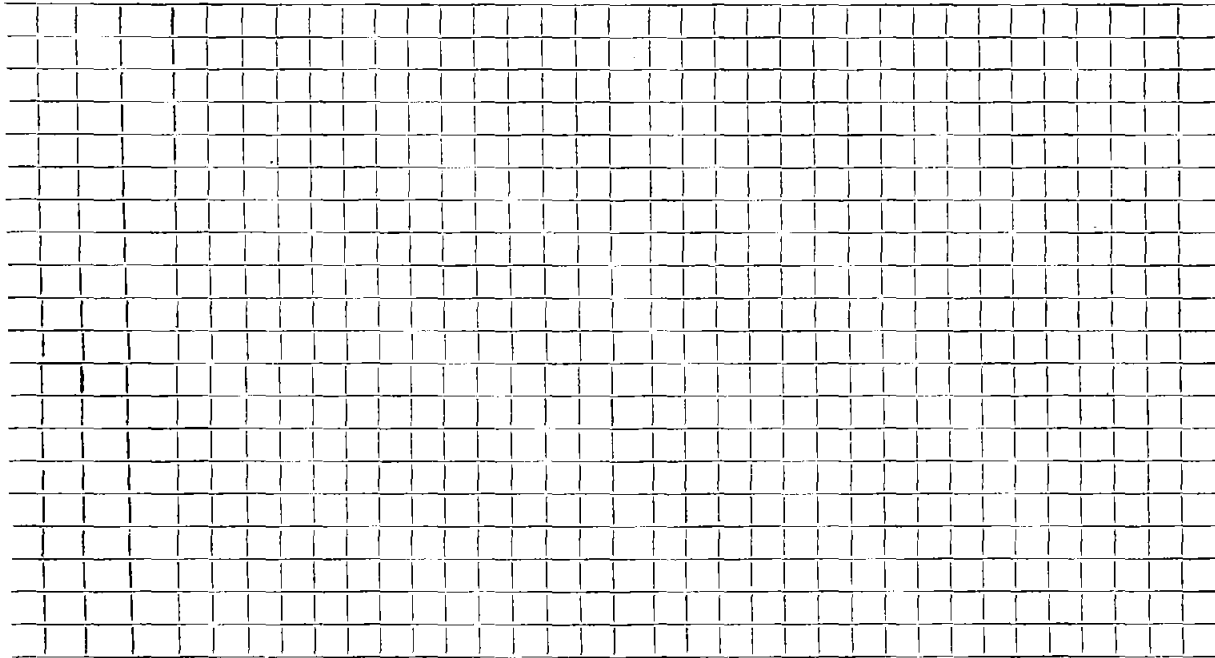
Date	Material	Amount	Total	Date		Amount
8-17-61	Labor	80.51		12-7-60	Deposit	150 00
8-18-61	Labor	7.11	87.62	9-25-61	Paid by WPC #1303	18 61
	10% O.H.		8.76	2-9-62	Paid	18 43
	1/2' 6" Transite pipe @.78		32.76			187 04
	1 6" 90° Transite Elbow		5.40			
	3 Hrs. Town Shovel @6.50		19.50			
	2 Hrs. Trucking @3.00		6.00			
	27' Patch		27.00			
			<u>187.04</u>			
				9-25-61	Call scd # 18.43	

DATE _____

TOWN OF LEXINGTON — BOARD OF PUBLIC WORKS

SEWER DIVISION

Sketch of Service Here

A large rectangular area filled with a grid of small squares, intended for sketching or drawing service details.

Connection made in Street. Work completed

Remarks:
.....
.....