

Name Claude A. Clarke

Service No. 159

Address # 75 Cedar St.

Location

Kind of Pipe

Size

Size of Main

~~Repair~~ ~~Renewal~~ ~~XXXXXX~~ New Service

Location Comm 12-8-58

Date	Material	Amount	Total	Date	Amount
10/10/58	labor	66 64		9-16-58	Deposit
	10% overhead	6 66		12-8-58	Retained
			73 30		159 05
	50' 6" transite pipe @ .70		35 00		
	3 hr. town shovel @ 6.50		19 50		
	3 hrs. trucking @ .75		2 25		
	1 hr. Rodger's Trailer @ 3.00		3 00		
	1 hr. trucking @ 3.00		3 00		
	1 hr. Trojan Loader @ 3.00		3 00		
	10x 10 patch		20 00		
			159 05		
	Labor				

TOWN OF LEXINGTON—DEPT. OF PUBLIC WORKS
SEWER DIVISION

DATE

NO.


The undersigned applies for the construction of a particular sewer connecting No.
Street and hereby agrees to comply with the Rules and Regulations governing the construction and use of Particular
Sewers, as now or at any future time established by the Board of Selectmen.

Am't of estimate \$.....

Am't Paid \$.....

..... Owner

Sketch of Service Here **75**

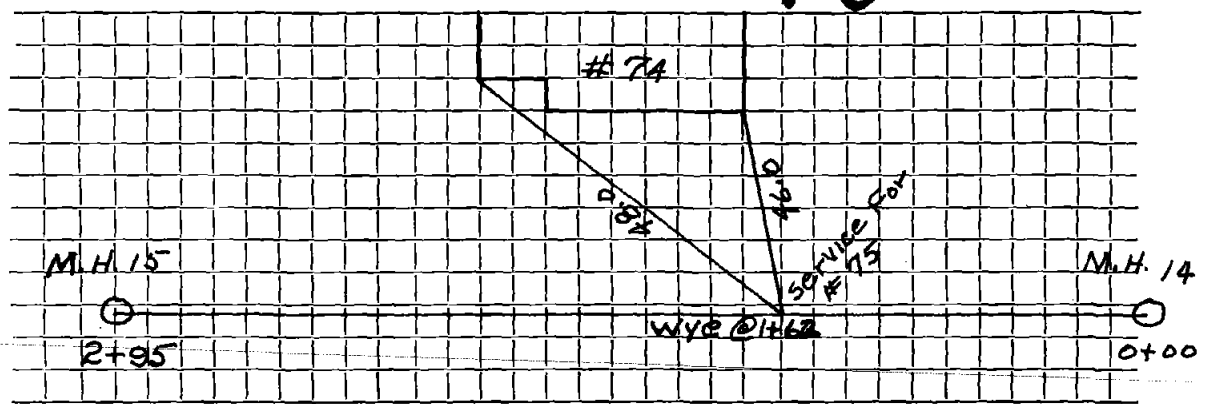

Connection made in Street.

Work completed 19..

Remarks: