

Name HOMES REALTY CORP.

Service No.

Address #80 CEDAR STREET

Location

Kind of Pipe

Size

Size of Main

Repair

Renewal

New Service

PERMIT NO. 0700 - MCLAUGHLIN

Location

Date

Material

Amount

Total

Date

Amount

9/10/95

6" PVC

9-16-58

64' 6" Transite

~~+ 6" Transite Bend~~

1 6"-22° Transite Bend

1 6"-11¼° Transite Bend


DATE 10 SEPTEMBER 1995

TOWN OF LEXINGTON — BOARD OF PUBLIC WORKS

SEWER DIVISION

Sketch of Service Here

80

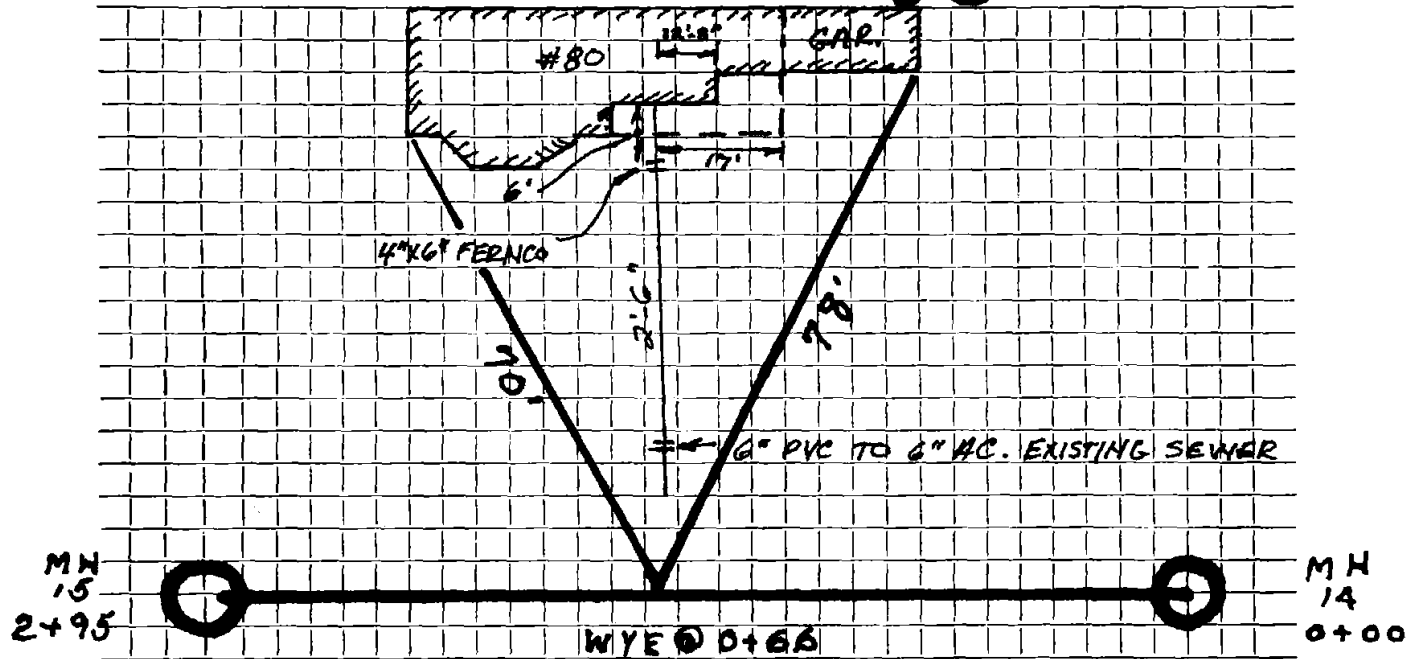

Connection made in CEDAR STREET Street. Work completed J.M. MCLAUGHLIN, INC.

Remarks:

BOOK 96A

J.W.