

Name Ross, Katherine
Address 9-11
Cedar Street

Service No. 8 131

Location

Kind of Pipe

Size

Size of Main

~~Repair~~ ~~Renewal~~ New Service

Location

Date	Material	Amount	Total	Date	Amount
5/11/31	Owner digs trench (to middle of street) supplies own pipe and stock, and lays pipe and makes connection.				
	Labor				

TOWN OF LEXINGTON—BOARD OF PUBLIC WORKS
SEWER DIVISION

DATE 5-11-31

NO. _____


The undersigned applies for the construction of a particular sewer connecting No. 5 Cedar St.
Street and hereby agrees to comply with the Rules and Regulations governing the construction and use of Particular
Sewers, as now or at any future time established by the Board of Selectmen.

Am't. of Estimate \$ _____

Am't. Paid \$ _____

Anthony Ross Owner
owner digs own trench to Center of St. by 1/2 in.

Sketch of Service Here

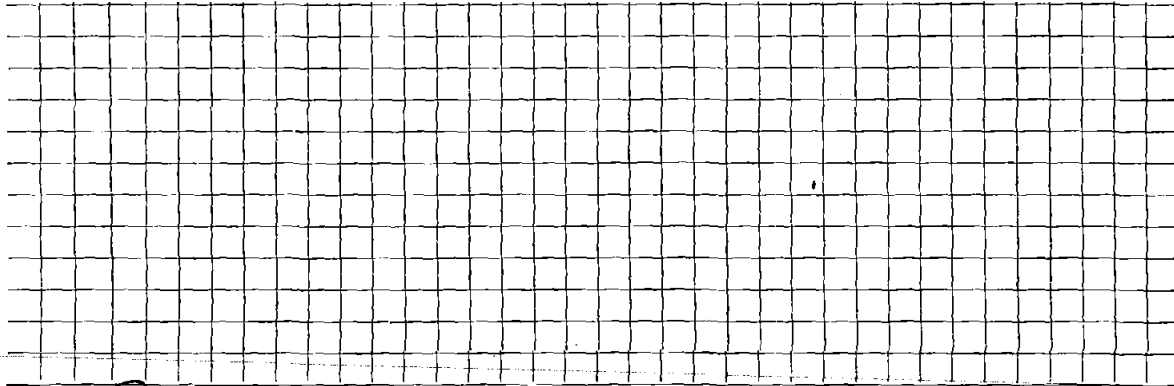

Connection made in Cedar St. Street. Work completed _____ 19

Remarks: