

Name Stanley Januwasas

Service No. 95

Address # 103 Cedar St.

Location

Kind of Pipe

Size

Size of Main

~~Repair-Renewal~~ New Service W.O. # 6896 Suburbanite #1454

Location

DEC 22 1969

Date	Material	Amount	Total	Date	Amount
9/30/69	Labor	103 44		9-9-69	Deposit 210 00
10/20/69	"	36 51	139 95		
10	4 O.H.		14 00	1-16-70	Paid 24 55
30	Transitepipe .88		26 40		
1	90o Elbow		4 09		234 55
2	Nipple		2 98		
2	Port cement 1.55				
1	6" Plug		1 93		
1	Ton cold patch		5 85		
2	Hrs. trucking 3.00		6 00		
1	" compressor		5 00		
1	" loader		4 00		
3	" Shovel 6.50		19 50		
1	" roller trailer		3 00		
	Labor		234 55		
10-14-69	51' 6" Transite pipe				
	15' 4" Cast Iron pipe				
					Bill sent 24.55

TOWN OF LEXINGTON—DEPT. OF PUBLIC WORKS

SEWER DIVISION

DATE


NO.

The undersigned applies for the construction of a particular sewer connecting No. Street and hereby agrees to comply with the Rules and Regulations governing the construction and use of Particular Sewers, as now or at any future time established by the Board of Selectmen.

Am't of estimate \$.....

Am't Paid \$.....

..... Owner

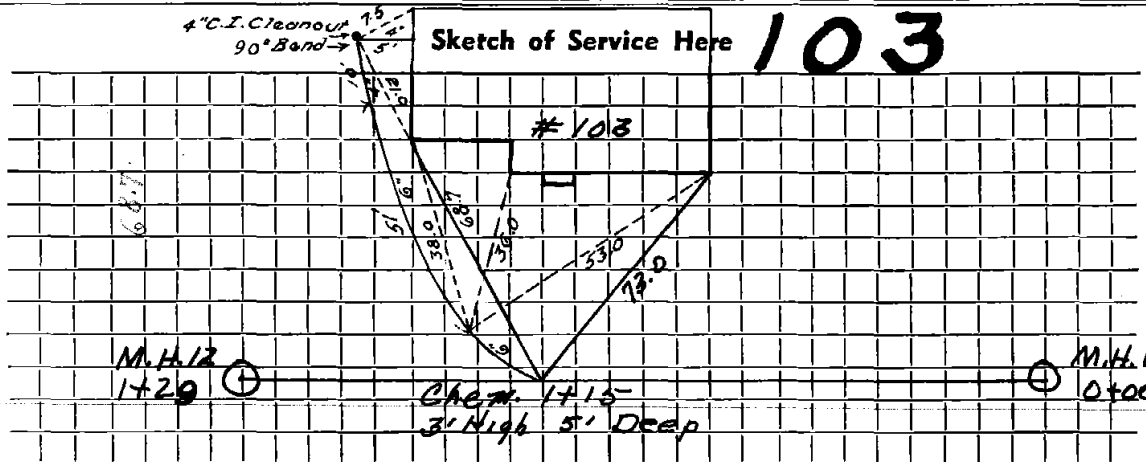

Connection made in Street.

Work completed 19..

Remarks: